

Pearl River
 X 66
 4-24-75

MISSISSIPPI
 BOARD OF WATER COMMISSIONERS
 416 North State Street
 Jackson, Mississippi 39201

WATER WELL DRILLERS LOG

CODED

4-24-1975 date well completed
 Bud Stanton & Son Pearl River firm name
 county well located

LANDOWNER:
 Jack Courtney
 Rt. 2, Picayune, Miss.
 (mailing address)

description of formation encountered	from	to
Red Shale	0	90
Blue shale	90	425
Grey sand	425	435

WELL LOCATION:
 sec. ~~8~~ T 6 N R 16 E 13V
 4 miles NE of Picayune
 (distance) (direction) (nearest town)

WELL PURPOSE: Home
 (home, irrigation, municipal, industrial)

- WELL COMPLETION DATA:
- diameter (inches) 2 in
 - total depth (feet) 435
 - static water level (feet) 25 below top of ground
 - casing PVC 425
 (material) (depth)
 _____ if telescope see back.
 (size)
 - screen 2x10 425
 (length) (depth to top)
12 PVC
 (size) (material)
 - pump 1 750
 (HP) (yield gpm)
electric
 (type power)
 - electric log NO
 (yes or no)

 (organization running log)
 - how well bottom plugged
Good Seal


DRILLERS REMARKS:

REGISTERED

JUN 23 1975

If well telescopes please
sketch and show depths.

GROUND LEVEL

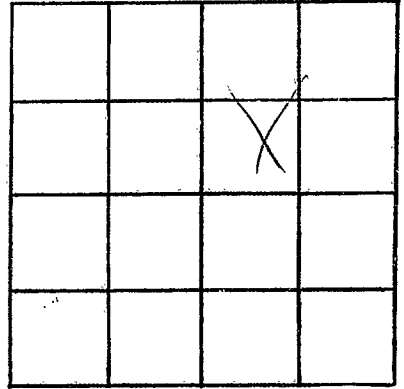

SECTION _____

Please indicate well location X.

ADDITIONAL INFORMATION

If more than one screen,
show locations of each on sketch.