

Pearl River
X 71
3-7-73

MISSISSIPPI
 BOARD OF WATER COMMISSIONERS
 416 North State Street
 Jackson, Mississippi 39201

CODED

WATER WELL DRILLERS LOG

3-7 1973 Penton Well serv Pearl River
 date well completed firm name county well located

LANDOWNER: W.C. Saunders

description of formations encountered	from	to
surface clay	0	16
Red sand	16	60
Blue clay	60	135
Fine sand	135	145
Blue clay	145	555
Sand	555	600

Picayune Miss
 (mailing address)

WELL LOCATION:
 sec. 15 T. 6 S. R. 16 W.
3 miles East of Picayune
 (distance) (direction) (nearest town)

WELL PURPOSE: Home
 (home, irrigation, municipal, industrial)

WELL COMPLETION DATA:

- (1) diameter (inches) 2
- (2) total depth (feet) 600
- (3) static water level (feet) 1 below top of ground. ~~above~~
- (4) casing Galv, 580
 (material) (depth)
2 if telescope see back.
 (size)
- (5) screen 10', 580
 (length) (depth to top)
2, S. steel
 (size) (material)
- (6) pump 1/2, 9
 (HP) (yield gpm)
Elec
 (type power)
- (7) electric log NO
 (yes or no)

CODED


(organization running log)

(8) how well bottom plugged Bl. Valve

DRILLERS REMARKS:

If well telescopes please sketch and show depths.

GROUND LEVEL

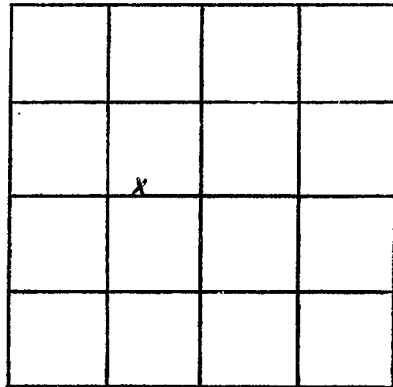

SECTION 15

Please indicate well location X.

ADDITIONAL INFORMATION

If more than one screen,
show locations of each on sketch.