

MISSISSIPPI
 BOARD OF WATER COMMISSIONERS
 416 North State Street
 Jackson, Mississippi 39201

CODED

WATER WELL DRILLERS LOG

Pearl River
X 72
2-21-73

2-21 1973 Pantons Well Serv Pearl River
 date well completed firm name county well located

LANDOWNER: J. E. Cochran
318 West Sycamore
Picayune MISS
 (mailing address)

description of formations encountered	from	to
	Surface Clay	0
Red Sand	20	38
White Clay	38	90
Blue Clay	90	190
Sand	190	229

WELL LOCATION:
 sec. 6 T. 6 S. R. 16 W.
1 miles NE of Picayune
 (distance) (direction) (nearest town)

WELL PURPOSE: Home
 (home, irrigation, municipal, industrial)

WELL COMPLETION DATA:

- (1) diameter (inches) 2
- (2) total depth (feet) 229
- (3) static water level (feet) 53 below top of ground.
- (4) casing Galv, 219,
 (material) (depth)
2 if telescope see back.
 (size)
- (5) screen 10', 219
 (length) (depth to top)
2, S. Steel
 (size) (material)
- (6) pump 1, 10
 (HP) (yield gpm)
Elec
 (type power)
- (7) electric log NO
 (yes or no)

CODED


(organization running log)

(8) how well bottom plugged BW Valve

DRILLERS REMARKS:

If well telescopes please sketch and show depths.

GROUND LEVEL

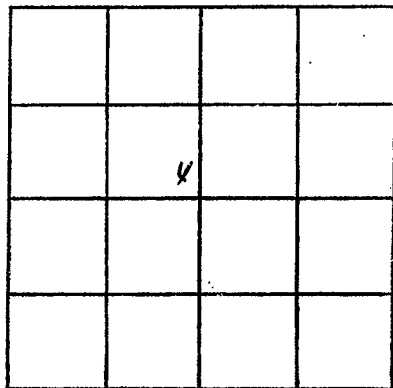

SECTION 6

Please indicate well location X.

ADDITIONAL INFORMATION

If more than one screen,
show locations of each on sketch.