

Pearl River
 X 73
 9-67

MISSISSIPPI
 BOARD OF WATER COMMISSIONERS
 416 North State Street
 Jackson, Mississippi 39201

134

CODED

WATER WELL DRILLERS LOG

9-30 1967 Penton Well Serv Pearl River
 date well completed firm name county well located

LANDOWNER: James Tate

description of formations encountered from to

Rd. 3

Picayune Miss
 (mailing address)

WELL LOCATION:
 sec. 17 T. 6 S. R. 16 W.
 1.5 miles East of Picayune
 (distance) (direction) (nearest town)

WELL PURPOSE: Home
 (home, irrigation, municipal, industrial)


WELL COMPLETION DATA:

- (1) diameter (inches) 5" Drilled
- (2) total depth (feet) 1008
- (3) static water level (feet) Flow above top of ground. +32
- (4) casing Black steel 988 (material) (depth)
 2" if telescope see back. (size)
- (5) screen 20 988 (length) (depth to top)
 0.12- 2" S. Steel (size) (material)
- (6) pump NO (HP) (yield gpm)
 (type power)
- (7) electric log NO (yes or no)
 (organization running log)
- (8) how well bottom plugged B.W. Valve

DRILLERS REMARKS: 14 lbs Shut in Pressure at Ground level

Yellow Clay	0	46
White Sand	46	53
" Clay	53	68
Brown Clay	68	90
Brown Sand	90	116
Blue Clay	116	260
Grey Sand	260	298
Blue Clay	298	365
Grey Sand	365	400
Blue Clay	400	415
Grey Sand	415	445
Blue Clay	445	612
Grey Sand	612	626
Blue Clay	626	648
Grey Sand	648	722
Blue Clay	722	755
Grey Sand	755	780
Blue Clay	780	826
Grey Sand	826	858
Blue Clay	858	

CODED

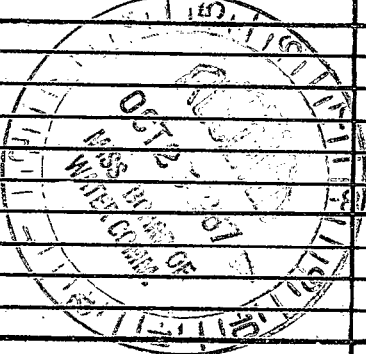

If well telescopes please sketch and show depths.

GROUND LEVEL

		X	

SECTION 17

Please indicate well location X.

ADDITIONAL INFORMATION

If more than one screen, show locations of each on sketch.