

Pearl River
 X74
 1-68

MISSISSIPPI
 BOARD OF WATER COMMISSIONERS
 416 North State Street
 Jackson, Mississippi 39201

CODED

WATER WELL DRILLERS LOG

JAN. 31, 1968 NEIL LUMPKIN WELL Pearl River
 date well completed firm name county well located
 DRILLING SERVICE

LANDOWNER: Bob Stewart
 Picayune, Miss.
 39466
 (mailing address)

description of formations encountered	from	to
Clay	0	15
Surface sand & gravel	15	70
Blue clay	70	200
Fine sand	200	265
Blue clay	265	300
Good pump well sand	300	405
Blue clay	405	755
"Good" sand	755	860
Blue clay	860	980
Good sand (fine to better)	980	1071

WELL LOCATION:
 sec 18 T 6 S R 16 E
 3 miles East of Picayune
 (distance) (direction) (nearest town)

WELL PURPOSE: Home
 (home, irrigation, municipal, industrial)

- WELL COMPLETION DATA:
- (1) diameter (inches) 2"
 - (2) total depth (feet) 1071'
 - (3) static water level (feet) 40' above top of ground. 712'
 - (4) casing metal, 1050'
 (material) (depth)
2" if telescope see back.
 (size)
 - (5) screen 20',
 (length) (depth to top)
2", Stainless Steel
 (size) (material)
 - (6) pump _____
 (HP) (yield gpm)

 (type power)
 - (7) electric log No
 (yes or no)


 (organization running log)
 - (8) how well bottom plugged Johnson BP Valve

CODED

DRILLERS REMARKS: 18 lbs. pressure

If well telescopes please sketch and show depths.

GROUND LEVEL

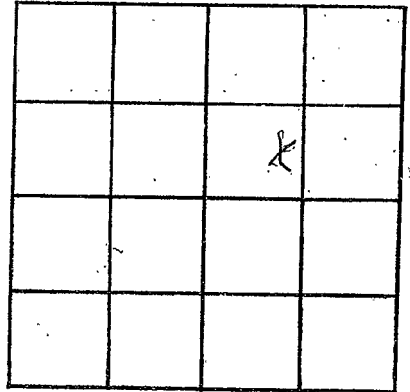

SECTION 18

Please indicate well location X.

ADDITIONAL INFORMATION

If more than one screen, show locations of each on sketch.