

PEARL RIVER
X 75
4-9-73

MISSISSIPPI
BOARD OF WATER COMMISSIONERS
416 North State Street
Jackson, Mississippi 39201

CODED

WATER WELL DRILLERS LOG

4-9 1973 date well completed
Lumpkin Well Co. firm name
Pearl River county well located

LANDOWNER: <i>Lumpkin Well Co.</i>	description of formations encountered	from	to
<i>Peayine Miss</i> (mailing address)	<i>Surface Clay</i>	0	35
	<i>Sand</i>	35	110
WELL LOCATION: sec. <u>9</u> T. <u>060</u> N. R. <u>76</u> E. <u>3</u> miles <u>N.E.</u> of <u>Peayine</u> (distance) (direction) (nearest town)	<i>Clay</i>	110	150
	<i>Sand</i>	150	210
WELL PURPOSE: (home, irrigation, municipal, industrial)	<i>Clay</i>	210	285
	<i>Sand</i>	285	315
WELL COMPLETION DATA: (1) diameter (inches) <u>2"</u> (2) total depth (feet) <u>636</u> (3) static water level (feet) <u>18'</u> below above top of ground. (4) casing <u>S.S.</u> , <u>626</u> , (material) (depth) <u> </u> If telescope see back. (size) (5) screen <u>10'</u> , (length) (depth to top) <u>2"</u> , <u>S. Seal</u> (size) (material) (6) pump <u>1</u> , <u>550</u> (HP) (yield gpm) <u>Glec.</u> <u>9</u> (type power) (7) electric log <u> </u> (yes or no) <u> </u> (organization running log) (8) how well bottom plugged <u>B.P.V.</u>	<i>Clay</i>	315	495
	<i>Fine Sand</i>	495	580
	<i>Hard Sand</i>	580	636


CODED

APR 20 1973

DRILLERS REMARKS:

If well telescopes please sketch and show depths.

GROUND LEVEL

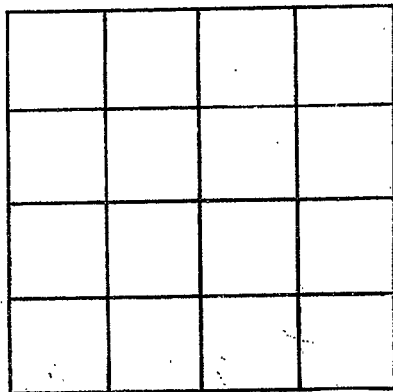

SECTION _____

Please indicate well location X.

ADDITIONAL INFORMATION

If more than one screen,
show locations of each on sketch.