

Pearl River
 X 76
 8-10-68

MISSISSIPPI
 BOARD OF WATER COMMISSIONERS
 416 North State Street
 134 Jackson, Mississippi 39201

WATER WELL DRILLERS **CODED**

8-10 1968 Neil Lumpkin Wells Pearl River
 date well completed DRILLING firm name SERVICE county well located

LANDOWNER: Nathan Farmer
 Piquemine, Miss.
 Route
 (mailing address)


WELL LOCATION:
 sec. 16 T 6 S R 16 E
 5 miles EAST of Piquemine
 (distance) (direction) (nearest town)

WELL PURPOSE: Home
 (home, irrigation, municipal, industrial)

WELL COMPLETION DATA:
 (1) diameter (inches) 2"
 (2) total depth (feet) 1008'
 (3) static water level (feet) 18.5 below top of ground.
 (4) casing iron, 988 (depth)
 2" (size) if telescope see back.
 (5) screen 20' (length), (depth to top)
 2" St. St. (size) (material)
 (6) pump (HP) (yield gpm)
 (type power)
 (7) electric log No (yes or no)
 (organization running log)
 (8) how well bottom plugged Johnson Back Pressure Valve

description of formations encountered	from	to
Clay	0	15
sand	15	53
Clay	55	265
sand	265	320
Clay	320	375
sand	375	420
Clay	420	700
sand	700	750
Clay	750	800
sand	800	875
Clay	875	920
Good sand	920	1008


CODED

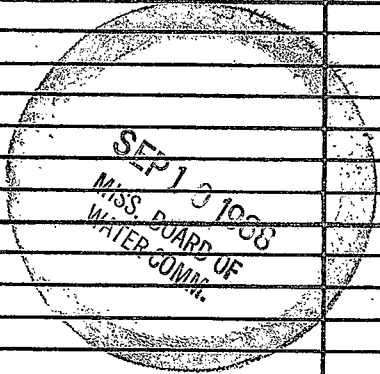

DRILLERS REMARKS: Belts pressure

If well telescopes please sketch and show depths.

GROUND LEVEL

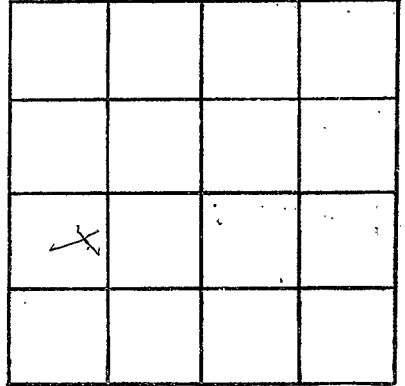

SECTION 16

Please indicate well location X.

ADDITIONAL INFORMATION

If more than one screen, show locations of each on sketch.