

Pearl River
 X 78
 8-26-75

MISSISSIPPI
 BOARD OF WATER COMMISSIONERS
 416 North State Street
 Jackson, Mississippi 39201

CODED

WATER WELL DRILLERS LOG

8-26 1975 Penton Well Serv Pearl River
 date well completed firm name county well located

LANDOWNER: Wendell Claff
11337 Old Spanish Trail
New Orleans La.
 (mailing address)

description of formations encountered	from	to
Surface Clay	0	24
Sand	24	65
White Clay	65	80
Blue Clay	80	520
Sand	520	598

WELL LOCATION:
 sec. 14 6 ^N _S R. 16 ^E _W 13S
4 1/2 miles East of Picayune
 (distance) (direction) (nearest town)

WELL PURPOSE: Home
 (home, irrigation, municipal, industrial)

- WELL COMPLETION DATA:
- (1) diameter (inches) 2
 - (2) total depth (feet) 598
 - (3) static water level (feet) 2' below top of ground.
 - (4) casing Galv. 588
 (material) (depth)
2 If telescope see back.
 (size)
 - (5) screen 10' 588
 (length) (depth to top)
2 S. Steel
 (size) (material)
 - (6) pump _____
 (HP) (yield gpm)

 (type power)
 - (7) electric log NO
 (yes or no)
 - _____ (organization running log)
 - (8) how well bottom plugged B.W. Valve


CODED

RECEIVED
 OCT - 2 1975

DRILLERS REMARKS:

If well telescopes please sketch and show depths.

GROUND LEVEL

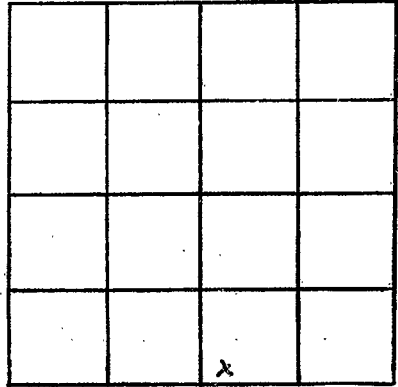

SECTION 14

Please indicate well location X.

ADDITIONAL INFORMATION

If more than one screen, show locations of each on sketch.