

X 80
 PEARL RIVER
 8-1-73

MISSISSIPPI
 BOARD OF WATER COMMISSIONERS
 416 North State Street
 Jackson, Mississippi 39201

COPIED

WATER WELL DRILLERS LOG

B-1 1973 Ponton Well Serv Pearl River
 date well completed firm name county well located

LANDOWNER: Earl Grabert
 Pt. 2
 Carriere Miss
 (mailing address)

description of formations encountered	from	to
surface clay	0	18
sand	18	65
blue clay	65	478
sand	478	542

WELL LOCATION:
 sec. 5 T. 6 N R. 16 E
 2 miles NE of Arcyane
 (distance) (direction) (nearest town)

WELL PURPOSE: Home
 (home, irrigation, municipal, industrial)


- WELL COMPLETION DATA:
- (1) diameter (inches) 2
 - (2) total depth (feet) 542
 - (3) static water level (feet) Flow below top of ground.
 - (4) casing Galv, 532, (material) (depth)
 2 (size) if telescope see back.
 - (5) screen 10, 532 (length) (depth to top)
 2, S. Steel (size) (material)
 - (6) pump (HP) (yield gpm)
 (type power)
 - (7) electric log NO (yes or no)
 (organization running log)
 - (8) how well bottom plugged BU Valve

DRILLERS REMARKS:

AUG 13 1973

If well telescopes please sketch and show depths.

GROUND LEVEL

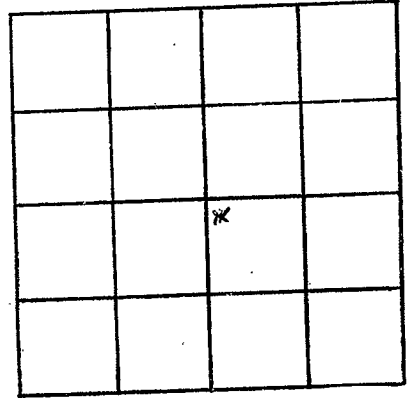

SECTION 5

Please indicate well location X.

ADDITIONAL INFORMATION

If more than one screen,
show locations of each on sketch.