

X 81  
 PEARL RIVER  
 7-18-73

MISSISSIPPI  
 BOARD OF WATER COMMISSIONERS  
 416 North State Street  
 Jackson, Mississippi 39201

CODED

WATER WELL DRILLERS LOG

7-18 1973 Penton Well Serv Pearl River  
 date well completed firm name county well located

LANDOWNER: Chas. Slaydon

description of formations encountered	from	to
Surface Clay	0	30
Sand	30	50
White Clay	50	80
Sand	80	120
Blue Clay	120	570
Sand	570	597

Picayune MISS  
 (mailing address)

WELL LOCATION:  
 sec. 16 T. 6 R. 16 E  
 3 miles East of Picayune  
 (distance) (direction) (nearest town)

WELL PURPOSE: Home  
 (home, irrigation, municipal, industrial)

WELL COMPLETION DATA:


- (1) diameter (inches) 2
- (2) total depth (feet) 597
- (3) static water level (feet) 1 below top of ground.
- (4) casing Galv, 587 (material), (depth)  
 2 (size) if telescope see back.
- (5) screen 10', 587 (length), (depth to top)  
 2, S. Steel (size), (material)
- (6) pump 1/2 (HP), 10 (yield gpm)  
 Elec (type power)
- (7) electric log No (yes or no)
- (organization running log)
- (8) how well bottom plugged BW. Valve

DRILLERS REMARKS:

AUG 12 1973

If well telescopes please sketch and show depths.

GROUND LEVEL

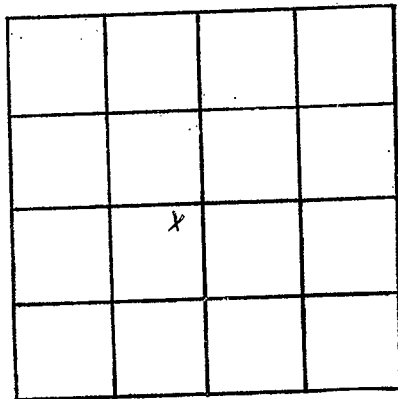

SECTION 16

Please indicate well location X.

ADDITIONAL INFORMATION

If more than one screen, show locations of each on sketch.