

P.R.
X 83
8-14-73

MISSISSIPPI
BOARD OF WATER COMMISSIONERS
416 North State Street
Jackson, Mississippi 39201

CODED
CODED

WATER WELL DRILLERS LOG

Pearl River

8-14-73 date well completed
Earl Penton water well serv. firm name
Pearl River county well located

LANDOWNER:
Mr. S. Lester Stewart
Pecayone miss.
(mailing address)

description of formations encountered	from	to
Red clay	0	20
white coarse sd.	20	40
white clay	40	96
Blue clay	96	125
Coarse Blue sd.	125	139

WELL LOCATION:
sec. 3 T. 6 N. R. 16 E
4 miles N.E. of Pecayone
(distance) (direction) (nearest town)

WELL PURPOSE: Home
(home, irrigation, municipal, industrial)

- WELL COMPLETION DATA:
- (1) diameter (inches) 4.5
 - (2) total depth (feet) 139
 - (3) static water level (feet) 29 below top of ground.
 - (4) casing P.V.C. 134 (material) (depth)
2" (size) if telescope see back.
 - (5) screen 5' P34 (length) (depth to top)
2 P.V.C. (size) (material)
 - (6) pump 1 400 H.P. (HP) (yield gpm)
ELECT (type power)
 - (7) electric log NO (yes or no)
 - (organization running log)
 - (8) how well bottom plugged shoe


CODED

DRILLERS REMARKS:

NOV 8 1973

1700.
If well telescopes please
sketch and show depths.

GROUND LEVEL

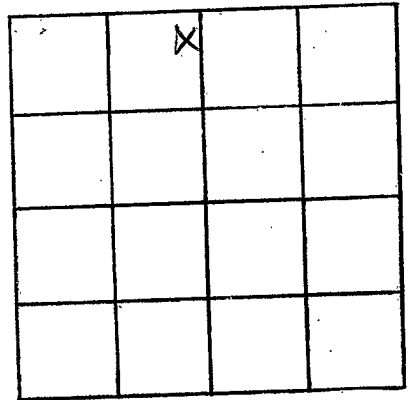

SECTION 3

Please indicate well location X.

ADDITIONAL INFORMATION

If more than one screen,
show locations of each on sketch.