

P.R.
X84
6-29-73

MISSISSIPPI
BOARD OF WATER COMMISSIONERS
416 North State Street
Jackson, Mississippi 39201

CODED

WATER WELL DRILLERS LOG

Leavel River

6-29-73 1973 Earl Penton water well serv.
date well completed firm name county well located

LANDOWNER:
Mr. Oswald Moller
Salem Miss.
(mailing address)

WELL LOCATION:
sec. 16 T. 6 N R. 16 E
5 miles East of Proctorville
(distance) (direction) (nearest town)

WELL PURPOSE: Home
(home, irrigation, municipal, industrial)

- WELL COMPLETION DATA:
- (1) diameter (inches) 4.5
 - (2) total depth (feet) 210
 - (3) static water level (feet) 20 below above top of ground.
 - (4) casing P.V.C. 205
(material) (depth)
 - 2"
(size) If telescope see back.
 - (5) screen 5' 205
(length) (depth to top)
 - 2" P.V.C.
(size) (material)
 - (6) pump 1/2 300
(HP) (yield gpm)
 - Elect
(type power)
 - (7) electric log NO
(yes or no)
 - (organization running log)
 - (8) how well bottom plugged Shoe


description of formations encountered	from	to
Red Clay	0	8
Co. w/ sd.	8	18
Red Clay	18	25
Co. sd. & Gravel	25	40
Red Clay	40	45
Fine Red sd.	45	54
Blue Clay	54	170
Med. Blue sd.	170	210
GULF		

NOV 8 1973

DRILLERS REMARKS:

If well telescopes please sketch and show depths.

GROUND LEVEL

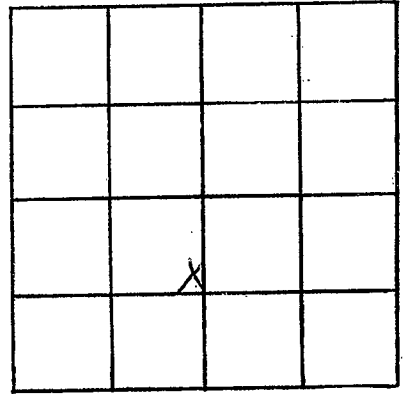

SECTION 16

Please indicate well location X.

ADDITIONAL INFORMATION

If more than one screen,
show locations of each on sketch.