

P.R.
X 85
5-26-73

MISSISSIPPI
BOARD OF WATER COMMISSIONERS
416 North State Street
Jackson, Mississippi 39201

COBED River

WATER WELL DRILLERS LOG

5-26 1973 Earl Penton water well serv.
date well completed firm name county well located

LANDOWNER: J
Mr. Wiley Horton
Picayune Miss.
(mailing address)

description of formations encountered	from	to
Red. clay	0	29
white clay	29	100
Blue. clay	100	120
Coarse Blue sd.	100	165

WELL LOCATION:
sec. 9 T. 6 N. R. 16 E.
4 miles west Picayune
(distance) (direction) (nearest town)

WELL PURPOSE: Home
(home, irrigation, municipal, industrial)

WELL COMPLETION DATA:

(1) diameter (inches) 4 5/8

(2) total depth (feet) 165

(3) static water level (feet) 16 below/above top of ground.

(4) casing P.V.C. 160'
(material) (depth)

2 (size) if telescope see back.

(5) screen 5' 160
(length) (depth to top)

2 (size) P.V.C. (material)

(6) pump 3/4 320
(HP) (yield gpm)

Elect. (type power)

(7) electric log no
(yes or no)

(organization running log)

(8) how well bottom plugged shoe


COBED

MADE 8 1973
MISS. Bd OF WATER COMMISSIONERS

DRILLERS REMARKS:

If well telescopes please sketch and show depths.

GROUND LEVEL

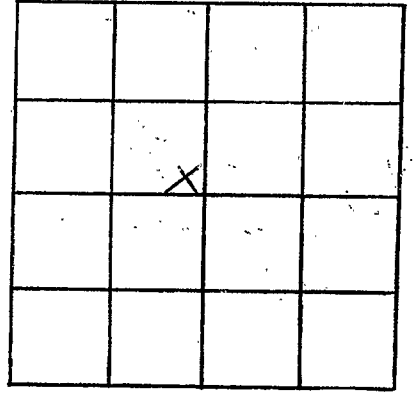

SECTION 9

Please indicate well location X.

ADDITIONAL INFORMATION

If more than one screen, show locations of each on sketch.