

P.R.  
X 86  
3-21-73

MISSISSIPPI  
BOARD OF WATER COMMISSIONERS  
416 North State Street  
Jackson, Mississippi 39201

**CODED**

WATER WELL DRILLERS LOG

Pearl River

3-21 1973  
date well completed

Earl Penton water well serv  
firm name

county well located

LANDOWNER:	description of formations encountered	from	to
Mr. Richard Speers Rt. 2, Corvieve, Miss. (mailing address)			
WELL LOCATION:	White clay	30	60
sec. 6 T. 6 N. R. 16 E 1 miles East of Pigeon (distance) (direction) (nearest town)	Blue clay	60	80
WELL PURPOSE: Home (home, irrigation, municipal, industrial)	Five Blue sd.	80	95
WELL COMPLETION DATA:	Blue clay	95	160
(1) diameter (inches) 4.75	Med Blue sd.	160	195
(2) total depth (feet) 195			
(3) static water level (feet) 27 below top of ground.			
(4) casing Galv. 190 (material) (depth)			
2 (size) if telescope see back.			
(5) screen 5 190 (length) (depth to top)			
2 (size) 5-5 (material)			
(6) pump 1 550 (HP) (yield gpm)			
Elect (type power)			
(7) electric log NO (yes or no)			
(organization running log)			
(8) how well bottom plugged Shoe			

DRILLERS REMARKS:

NOTE


MISSISSIPPI BOARD OF WATER COMMISSIONERS

If well telescopes please sketch and show depths.



GROUND LEVEL

---

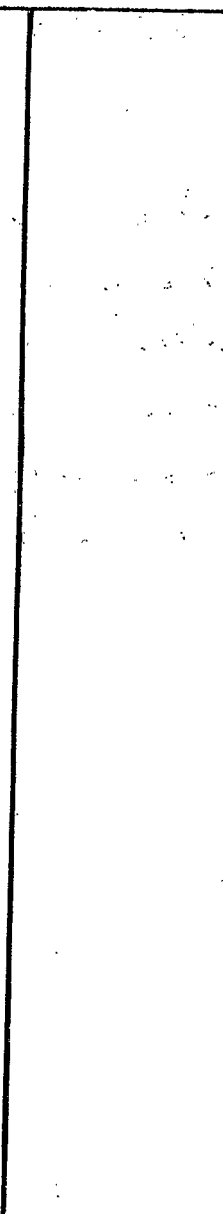

X			

SECTION 6

Please indicate well location X.

ADDITIONAL INFORMATION

If more than one screen, show locations of each on sketch.

