

MISSISSIPPI  
BOARD OF WATER COMMISSIONERS  
416 North State Street  
Jackson, Mississippi 39201

**CODED**

**WATER WELL DRILLERS LOG**

8/23 1973 Anderton & Sons Pearl River  
date well completed firm name county well located

LANDOWNER: J. Loyd

Lucas Picoy  
Miss.

(mailing address)

WELL LOCATION:

sec. 6 T. 6 N. R. 16 E.  
2 miles N.E. of Picoy  
(distance) (direction) (nearest town)

WELL PURPOSE: home  
(home, irrigation, municipal, industrial)

WELL COMPLETION DATA:

- (1) diameter (inches) 2"
- (2) total depth (feet) 1509
- (3) static water level (feet) 186 below top of ground.
- (4) casing galv. 1489  
(material) (depth)

\_\_\_\_\_ if telescope see back.  
(size)

- (5) screen 2x20 1489  
(length) (depth to top)  
2x20 galv. # 12  
(size) (material)

- (6) pump \_\_\_\_\_ 3800  
(HP) (yield gpm)
- (type power)

- (7) electric log no  
(yes or no)


(organization running log)

- (8) how well bottom plugged sharh.

DRILLERS REMARKS: solid  
Rock 1450

description of formations encountered	from	to
white shale	0	28
white sand	28	63
blue shale	63	257
blue sand	257	276
blue shale	276	496
gray sand	496	580
blue shale	580	760
gray sand	760	790
blue shale	790	896
gray sand	896	948
blue shale	948	1008
gray sand	1008	1108
blue shale	1108	1450
about 3 ft solid rock	1450	1453
gray sand	1453	1509


**CODED**

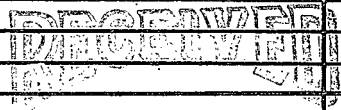

JAN 7 1974

If well telescopes please sketch and show depths.

GROUND LEVEL

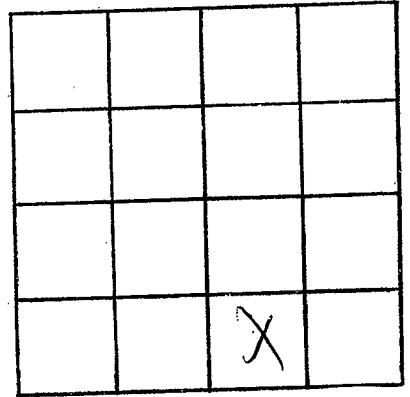

SECTION \_\_\_\_\_

Please indicate well location X.

ADDITIONAL INFORMATION

If more than one screen, show locations of each on sketch.