

P.R.
 X 88
 8-30-73

MISSISSIPPI
 BOARD OF WATER COMMISSIONERS
 416 North State Street
 Jackson, Mississippi 39201

CODED

WATER WELL DRILLERS LOG

8-30 1973 Bud Luter & Son Lead River
 date well completed firm name county well located

LANDOWNER: Johnny Fugh
Scayne, Miss.

description of formations encountered	from	to
<u>white shale</u>	<u>0</u>	<u>22</u>
<u>white sand</u>	<u>22</u>	<u>45</u>
<u>blue shale</u>	<u>45</u>	<u>518</u>
<u>blue shale</u>	<u>45</u>	<u>518</u>
<u>blue sand</u>	<u>518</u>	<u>535</u>

(mailing address)

WELL LOCATION:

sec. 12 T. 6 N. R. 16 E.
14 miles E of Scayne
 (distance) (direction) (nearest town)

WELL PURPOSE: Home
 (home, irrigation, municipal, industrial)

WELL COMPLETION DATA:

- (1) diameter (inches) 2 in.
- (2) total depth (feet) 535
- (3) static water level (feet) 6 ft. below top of ground.
- (4) casing Galv. 495
 (material) (depth)

CODED

_____ if telescope see back.
 (size)

- (5) screen 2x10 495
 (length) (depth to top)
2x10 Galv. no. 12
 (size) (material)


- (6) pump _____ (HP) _____ (yield gpm)
flow
 (type power)

- (7) electric log no
 (yes or no)

_____ (organization running log)

- (8) how well bottom plugged Good


DRILLERS REMARKS:

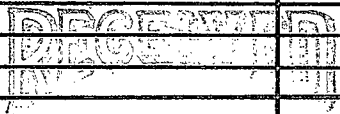

JAN 7 1974

If well telescopes please sketch and show depths.

GROUND LEVEL

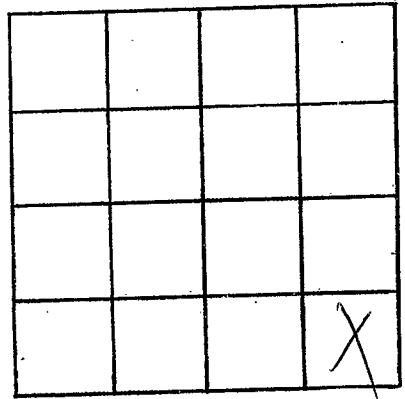

SECTION _____

Please indicate well location X.

ADDITIONAL INFORMATION

If more than one screen, show locations of each on sketch.