

P.R.
X89
12-19-73

MISSISSIPPI *Walter Penton*
BOARD OF WATER COMMISSIONERS
416 North State Street
Jackson, Mississippi 39201

WATER WELL DRILLERS LOG

CODED

12-19 1973 *Penton Well Serv* *Pearl River*
date well completed firm name county well located

LANDOWNER: *Tom McDonald*
Picayune Miss

description of formations encountered	from	to
<i>Surface clay</i>	<i>0</i>	<i>25</i>
<i>SAND</i>	<i>25</i>	<i>60</i>
<i>Blue clay</i>	<i>60</i>	<i>200</i>
<i>SAND</i>	<i>200</i>	<i>272</i>

(mailing address)

WELL LOCATION:
sec. *6 T 6* R. *16*
1 miles *NE* of *Picayune*
(distance) (direction) (nearest town)

CODED

WELL PURPOSE: *Home*
(home, irrigation, municipal, industrial)


WELL COMPLETION DATA:

- (1) diameter (inches) *2*
- (2) total depth (feet) *272*
- (3) static water level (feet) *52* below top of ground.
- (4) casing *Galv* *262*
(material) (depth)
2 if telescope see back.
(size)
- (5) screen *10* *262*
(length) (depth to top)
2 *S. steel*
(size) (material)
- (6) pump *1* *10*
(HP) (yield gpm)
Elec
(type power)
- (7) electric log *No*
(yes or no)
- (organization running log)
- (8) how well bottom plugged *Box Valve*

DRILLERS REMARKS:

If well telescopes please sketch and show depths.

GROUND LEVEL

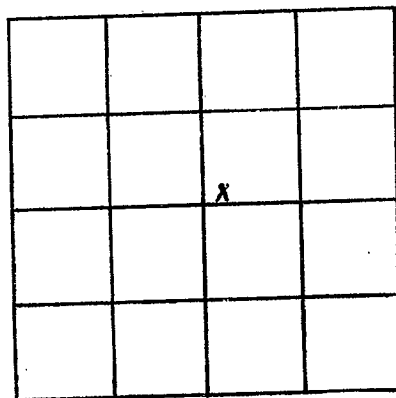

SECTION 6

Please indicate well location X.

ADDITIONAL INFORMATION

If more than one screen, show locations of each on sketch.