

P. R.
X90
10-3-74

MISSISSIPPI
BOARD OF WATER COMMISSIONERS
416 North State Street
Jackson, Mississippi 39201

WATER WELL DRILLERS LOG

CODED

10-3 date well completed
1974 Lumber Well Ser. firm name
Pearl River county well located

LANDOWNER: C. F. Skipper
Pearl River, Miss.
(mailing address)

description of formations encountered	from	to
Surface Clay	0	15
Surface Sand	15	68

WELL LOCATION:
sec. 16 T. 6 N. R. 16 E.
2 miles West of Pearl River
(distance) (direction) (nearest town)

WELL PURPOSE: Home
(home, irrigation, municipal, industrial)

- WELL COMPLETION DATA:
- (1) diameter (inches) 2"
 - (2) total depth (feet) 68'
 - (3) static water level (feet) 25' below top of ground.
 - (4) casing P.V.C. 63' (material) (depth)
2" If telescope see back. (size)
 - (5) screen 5' 68' (length) (depth to top)
2" P.V.C. (size) (material)
 - (6) pump 1/2 500 gpm. (HP) (yield gpm)
Elec. (type power)
 - (7) electric log No. (yes or no)

(organization running log)
(8) how well bottom plugged: Several blocks

DRILLERS REMARKS:


CODED

RECEIVED

DEC - 6 1974

If well telescopes please sketch and show depths.

GROUND LEVEL

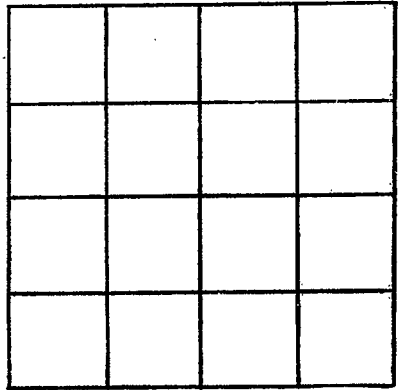

SECTION _____

Please indicate well location X.

ADDITIONAL INFORMATION

If more than one screen,
show locations of each on sketch.