

P.R.
X91
11-28-74

MISSISSIPPI
BOARD OF WATER COMMISSIONERS
416 North State Street
Jackson, Mississippi 39201

CODED

WATER WELL DRILLERS LOG

11-28 1974 Lumpkin Well Ser. Pearl River
date well completed. firm name county well located

LANDOWNER:
Mr. A. S. Davis
R. T. Picayune, Miss
(mailing address)

description of formations encountered	from	to
Clay	0	18
Sand	18	30
Clay	30	145
Sand	145	190
Clay	190	530
Sand	530	574

WELL LOCATION:
sec. 14 T 6 N R 16 E
6 1/2 miles W of Picayune
(distance) (direction) (nearest town)

WELL PURPOSE: Home
(home, irrigation, municipal, industrial)

WELL COMPLETION DATA:

(1) diameter (inches) 2"

(2) total depth (feet) 574'

(3) static water level (feet) 20' below above top of ground.

(4) casing P.V.C., 526'
(material) (depth)
2" if telescope see back.
(size)

(5) screen 10', 526'
(length) (depth to top)
2", P.V.C.
(size) (material)

(6) pump 1, 700 G.P.H.
(HP) (yield gpm)
Electric
(type power)

(7) electric log No
(yes or no)

(organization running log)

(8) how well bottom plugged Sand Shrub


CODED

DRILLERS REMARKS:

REGISTERED
DEC - 6 1974

If well telescopes please sketch and show depths.

GROUND LEVEL

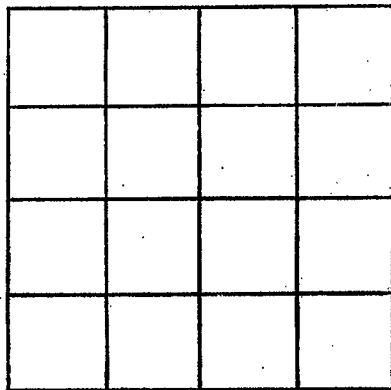

SECTION _____

Please indicate well location X.

ADDITIONAL INFORMATION

If more than one screen,
show locations of each on sketch.