

P.R.  
X92  
12-11-74

MISSISSIPPI  
BOARD OF WATER COMMISSIONERS  
416 North State Street  
Jackson, Mississippi 39201

COUED

WATER WELL DRILLERS LOG

12-11 date well completed      1974 Lumber Well Ser. firm name      Paul River county well located

LANDOWNER:	description of formations encountered	from	to
Mrs. Mamie Mitchell			
Rt. 1. Carrie Miss (mailing address)	Clay	0	15
	Sand	15	60
	Clay	60	190
	Sand	190	260
WELL LOCATION:			
sec. 3 T. 6 N. R. 10 E 2 miles East of Raymond (distance) (direction) (nearest town)			
WELL PURPOSE: Home (home, irrigation, municipal, industrial)			
WELL COMPLETION DATA:			
(1) diameter (inches) 2"			
(2) total depth (feet) 260'			
(3) static water level (feet) 35' below top of ground.			
(4) casing P.V.C., 255' (material) (depth)			
2" If telescope see back. (size)			
(5) screen 5' , 255' (length) (depth to top)			
2" P.V.C. (size) (material)			
(6) pump 1 600 g.p.m. (HP) (yield gpm)			
Electric (type power)			
(7) electric log No (yes or no)			
(organization running log)			
(8) how well bottom plugged Sand			
DRILLERS REMARKS:			


COUED

RECEIVED  
JAN 22 1975

MISS. BD. OF WATER COMM

If well telescopes please sketch and show depths.

GROUND LEVEL

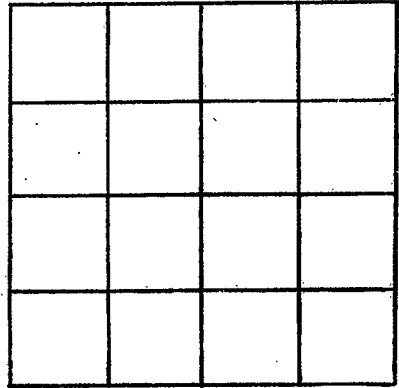

SECTION \_\_\_\_\_

Please indicate well location X.

ADDITIONAL INFORMATION

If more than one screen, show locations of each on sketch.