

Pearl River
X 93
2-27-75

MISSISSIPPI
 BOARD OF WATER COMMISSIONERS
 416 North State Street
 Jackson, Mississippi 39201

CODED

WATER WELL DRILLERS LOG

2-27 1975 Penton Well Serv Pearl River
 date well completed firm name county well located

LANDOWNER: Sherman Mattocks
Rt. 1 Box 202
Picayune Miss
 (mailing address)

description of formations encountered	from	to
Surface Clay	0	24
Sand	24	58
White Clay	58	90
Blue Clay	90	560
Sand	560	601

WELL LOCATION:
 sec. 16 T. 6 N. R. 16 E
 S. W.
3 miles East of Picayune
 (distance) (direction) (nearest town)

WELL PURPOSE: Home
 (home, irrigation, municipal, industrial)

WELL COMPLETION DATA:

(1) diameter (inches) 2

(2) total depth (feet) 601

(3) static water level (feet) 4 ~~below~~ above top of ground.

(4) casing Galv., 591,
 (material) (depth)
2 if telescope see back.
 (size)

(5) screen 10', 591
 (length) (depth to top)
2, St Steel
 (size) (material)


(6) pump 1/2, 9
 (HP) (yield gpm)
Elec.
 (type power)

(7) electric log NO
 (yes or no)

(organization running log)

(8) how well bottom plugged Bo. Valve

CODED

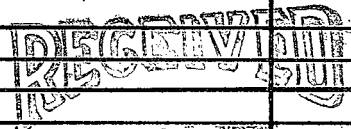

APR 10 1975

DRILLERS REMARKS:
Water Level - 4 Ft.

If well telescopes please sketch and show depths.

GROUND LEVEL

X			

SECTION 16

Please indicate well location X.

ADDITIONAL INFORMATION

If more than one screen, show locations of each on sketch.