

Pearl River  
 X 94  
 3-14-75

MISSISSIPPI  
 BOARD OF WATER COMMISSIONERS  
 416 North State Street  
 Jackson, Mississippi 39201

CODED

WATER WELL DRILLERS LOG

B-14 1975 Bud Pate & Son Pearl River  
 date well completed firm name county well located

LANDOWNER: Ernest Davis

Ocean Springs, Miss.  
 (mailing address)

description of formations encountered	from	to
White Shale	0	9
White Sand	9	75
Blue Shale	75	175
Blue Sand Fine	175	230
Blue Shales	230	360
Grey Sand & Rock	360	410

WELL LOCATION:

sec. 7 T. 6 N. R. 16 E.  
 1 miles SE of Ocean Springs  
 (distance) (direction) (nearest town)

WELL PURPOSE: Home  
 (home, irrigation, municipal, industrial)

WELL COMPLETION DATA:

- (1) diameter (inches) 2
- (2) total depth (feet) 410
- (3) static water level (feet) 116 below top of ground
- (4) casing PVC 400 (material) (depth)

CODED


(size) if telescope see back.  
 (5) screen 2 1/2" 400 (length) (depth to top)

2 1/2" PVC (size) (material)  
 (6) pump 3/4 600 (HP) (yield gpm)

electric (type power)  
 (7) electric log No (yes or no)

(organization running log)


(8) how well bottom plugged Sand Shale

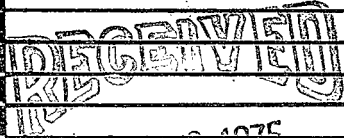

DRILLERS REMARKS:

If well telescopes please sketch and show depths.

GROUND LEVEL

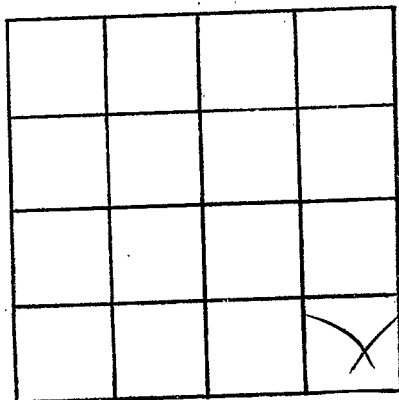

SECTION \_\_\_\_\_

Please indicate well location X.

ADDITIONAL INFORMATION

If more than one screen,  
show locations of each on sketch.