

MISSISSIPPI
 BOARD OF WATER COMMISSIONERS
 416 North State Street
 Jackson, Mississippi 39201

CODED

WATER WELL DRILLERS LOG

Pearl River
 X95
 2-22-75

2-22-75 date well completed
 Bud Pinter & Son firm name
 Pearl River county well located

LANDOWNER: Sam Blue
Pearl River, Miss

description of formations encountered	from	to
<u>White Shale</u>	<u>0</u>	<u>8</u>
<u>White Sand & Rock</u>	<u>8</u>	<u>35</u>
<u>Blue Shale</u>	<u>35</u>	<u>57</u>
<u>Grey Sand & Rock</u>	<u>57</u>	<u>58</u>

(mailing address)

WELL LOCATION:
 sec. 12 T. 6 N. R. 16 E.
S miles (distance) E (direction) of Pearl River (nearest town)

WELL PURPOSE: Home
 (home, irrigation, municipal, industrial)


- WELL COMPLETION DATA:
- (1) diameter (inches) 2
 - (2) total depth (feet) 598
 - (3) static water level (feet) 444 below top of ground
 - (4) casing Galv. (material) 588 (depth)
 - (size) if telescope see back.
 - (5) screen 2x10 (length) 588 (depth to top)
 - 2x10 (size) Stainless Steel (material)
 - (6) pump (HP) (yield gpm)
 - 160 (type power)
 - (7) electric log no (yes or no)

CODED

(organization running log)

(8) how well bottom plugged
Good


DRILLERS REMARKS:

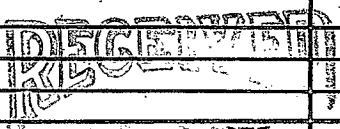

APR - 3 1975

If well telescopes please sketch and show depths.

GROUND LEVEL

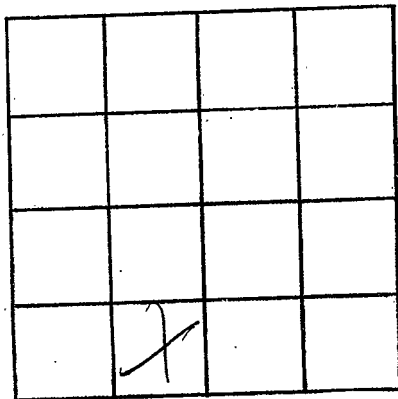

SECTION _____

Please indicate well location X.

ADDITIONAL INFORMATION

If more than one screen,
show locations of each on sketch.