

Pearl R.
 X 96
 1-17-75

MISSISSIPPI
 BOARD OF WATER COMMISSIONERS
 416 North State Street
 Jackson, Mississippi 39201

CODED

WATER WELL DRILLERS LOG

1-17
 date well completed

1975 Penton Well Serv
 firm name

Pearl River
 county well located

LANDOWNER: Lyonell Spiers

Picayune, MS.

(mailing address)

description of formations
 encountered

from to

Surface Clay	0	35
Sand	35	55
White Clay	55	95
Blue Clay	95	460
Sand	460	546

WELL LOCATION:

sec. 5 T. 6 R. 16
1 1/2 miles NE of Picayune
 (distance) (direction) (nearest town)

CODED

WELL PURPOSE: Home
 (home, irrigation, municipal, industrial)

WELL COMPLETION DATA:

- (1) diameter (inches) 2
- (2) total depth (feet) 546
- (3) static water level (feet) Flow ^{below} above top of ground.
- (4) casing Galv., 536,
 (material) (depth)
2 If telescope see back.
 (size)
- (5) screen 10', 536
 (length) (depth to top)
2, S. Steel
 (size) (material)
- (6) pump 1/2, 12
 (HP) (yield gpm)
Elec
 (type power)
- (7) electric log NO
 (yes or no)

(organization running log)

(8) how well bottom plugged Bl. Valve

DRILLERS REMARKS:


RECEIVED

APR 10 1975

MISS. BD. OF WATER COMMISSIONERS

If well telescopes please sketch and show depths.

GROUND LEVEL

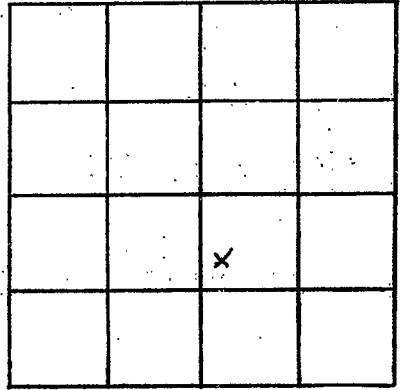

SECTION 5

Please indicate well location X.

ADDITIONAL INFORMATION

Lined area for additional information.

If more than one screen, show locations of each on sketch.