

X 97
 Pearl River
 5/16/75

MISSISSIPPI
 BOARD OF WATER COMMISSIONERS
 416 North State Street
 Jackson, Mississippi 39201

CODED

WATER WELL DRILLERS LOG

5-16 1975 Pantan Well Serv Pearl River
 date well completed firm name county well located

LANDOWNER: David Whitfield	description of formations encountered	from	to
Pt. 1			
Picayune MS- (mailing address)	Surface clay	0	10
	Sand	10	50
	Blue clay	50	230
	Sand	230	276

WELL LOCATION:
 sec. 18 T. 6 N R. 16 E
 S W
 1/2 miles East of Picayune
 (distance) (direction) (nearest town)

WELL PURPOSE: Home
 (home, irrigation, municipal, industrial)

- WELL COMPLETION DATA:
- (1) diameter (inches) 2
 - (2) total depth (feet) 276
 - (3) static water level (feet) 20 below above top of ground.
 - (4) casing Galv 266 (material) (depth)
 2 (size) If telescope see back.
 - (5) screen 10' 266 (length) (depth to top)
 2 3. Steel (size) (material)
 - (6) pump 1/2 9 (HP) (yield gpm)
 Elec (type power)
 - (7) electric log NO (yes or no)

(organization running log)

(9) how well bottom plugged B.W. Valve


REMARKS:

RECEIVED
 MAY 9 1975

MISS. BU. OF WATER COMMISSIONERS

If well telescopes please sketch and show depths.

GROUND LEVEL

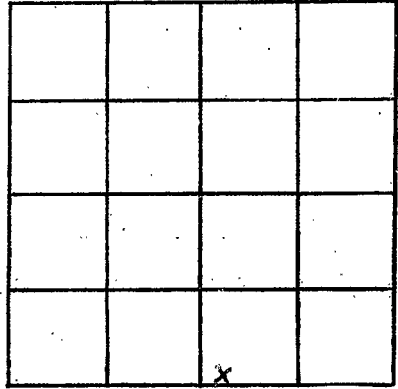

SECTION 18

Please indicate well location X.

ADDITIONAL INFORMATION

If more than one screen, show locations of each on sketch.