

Pearl R.  
X 112  
12-20-76

MISSISSIPPI  
BOARD OF WATER COMMISSIONERS  
416 North State Street  
Jackson, Mississippi 39201 **CODED**

WATER WELL DRILLERS LOG

12-20-76  
date well completed

1976 Bud Kenton & Son Paul Kline  
firm name county well located

LANDOWNER:

James Whitfield  
Rt. 3, Carriere, Miss.  
(mailing address)

description of formations encountered

from to

white shale	0	44
white sand	44	125
blue shale	125	267
blue sand	267	305
blue shale	305	326
gray sand	326	596
blue shale	596	985
gray sand	985	1120
gray shale	1120	1312
gray sand	1485	1512

WELL LOCATION:

sec 8 T 6 N R 16 E  
1 1/2 miles S E of Ecayne  
(distance) (direction) (nearest town)

WELL PURPOSE:

Home  
(home, irrigation, municipal, industrial)

WELL COMPLETION DATA:

- (1) diameter (inches) 2 in
- (2) total depth (feet) 1512
- (3) static water level (feet) 16 1/2 below/above top of ground.
- (4) casing Galv. 1482  
(material) (depth)
- \_\_\_\_\_ if telescope see back.  
(size)
- (5) screen 30 1482  
(length) (depth to top)
- 2 in S. Steel  
(size) (material)
- (6) pump \_\_\_\_\_ 16 1/2 h.  
(HP) (yield gpm)
- 110  
(type power)
- (7) electric log \_\_\_\_\_  
(yes or no)
- \_\_\_\_\_ (organization running log)

CODED

(8) how well bottom plugged  
Sand Shale


DRILLERS REMARKS:

RECEIVED  
APR 15 1977

MISS. BD. OF WATER COMMISSIONERS

If well telescopes please sketch and show depths.

GROUND LEVEL

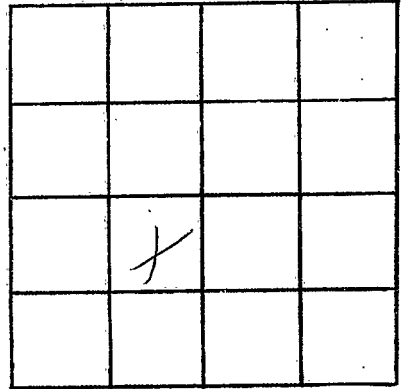

SECTION \_\_\_\_\_

Please indicate well location X.

ADDITIONAL INFORMATION

If more than one screen,  
show locations of each on sketch.