

Pearl River  
 Y 113  
 3-30-77

MISSISSIPPI  
 BOARD OF WATER COMMISSIONERS  
 416 North State Street  
 13V Jackson, Mississippi 39201

CODED

WATER WELL DRILLERS LOG

3-30 1977 Bud Benton Pearl River  
 date well completed firm name county well located

LANDOWNER: Mike Lilly  
 Rt. 3  
 Carrum, Miss.  
 (mailing address)

WELL LOCATION:  
 sec. 8 T. 6 N. R. 16 E  
 X 2 1/2 miles E of Ocean Springs  
 (distance) (direction) (nearest town)

WELL PURPOSE: Home  
 (home, irrigation, municipal, industrial)

WELL COMPLETION DATA:

(1) diameter (inches) 2 in  
 (2) total depth (feet) 1070  
 (3) static water level (feet) 4 ft above top of ground  
 (4) casing 2 1/2" Galv., 1050 (material) (depth)  
 (size) if telescope see back.  
 (5) screen 20 1050 (length) (depth to top)  
 2 in S. Steel (size) (material)  
 (6) pump (HP) (yield gpm)  
 1/2 (type power)  
 (7) electric log No (yes or no)  
 (organization running log)

description of formations encountered	from	to
White shale	0	18
White sands	18	76
Blue shale	76	218
Grey sand	118	235
Black shale	235	478
Grey sand	478	625
Blue shaly	625	960
Grey sand	960	1050

CODED


(8) how well bottom plugged  
 Mud Shark

DRILLERS REMARKS:

RECEIVED

If well telescopes please sketch and show depths.

GROUND LEVEL

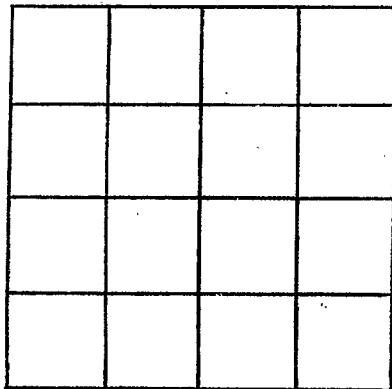

SECTION \_\_\_\_\_

Please indicate well location X.

ADDITIONAL INFORMATION

If more than one screen,  
show locations of each on sketch.