

Pearl River  
 X 115  
 12-15-77

MISSISSIPPI  
 BOARD OF WATER COMMISSIONERS  
 416 North State Street  
 Jackson, Mississippi 39201

CODED

WATER WELL DRILLERS LOG

12-15-77 19 date well completed  
 PENTON Well Serv firm name  
 Pearl River county well located

LANDOWNER: Jack Jones  
 Picayune, Ms. (mailing address)  
 WELL LOCATION:  
 sec. 6 T. 6 N. R. 16 E. S. 5 W.  
1/2 miles NE of Picayune  
 (distance) (direction) (nearest town)  
 WELL PURPOSE: Home  
 (home, irrigation, municipal, industrial)

description of formations encountered	from	to
Clay	0	20
Sand	20	50
Blue Clay <b>CODED</b>	50	180
Sand -	180	210
Blue Clay	210	380
Sand	380	428

WELL COMPLETION DATA:  
 (1) diameter (inches) 2"  
 (2) total depth (feet) 428'  
 (3) static water level (feet) 42' below/above top of ground.  
 (4) casing Galv. 418'  
 (material) (depth)  
2" if telescope see back.  
 (size)  
 (5) screen 10' 418'  
 (length) (depth to top)  
2" 3 Steel  
 (size) (material)  
 (6) pump 1 10  
 (HP) (yield gpm)  
Elec.  
 (type power)  
 (7) electric log NO  
 (yes or no)  
 (organization running log)

(8) how well bottom plugged B.W. Valve


DRILLERS REMARKS:

RECEIVED  
 DEC 27 1977

MISS. BD. OF WATER COMMISSIONERS

If well telescopes please sketch and show depths.

GROUND LEVEL

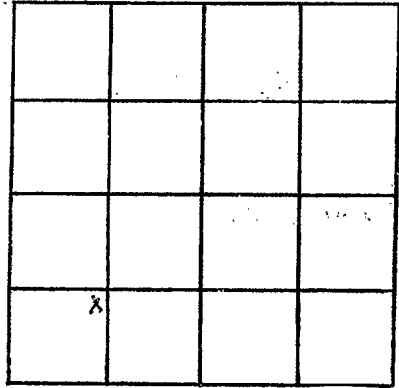

SECTION 6

Please indicate well location X.

ADDITIONAL INFORMATION

A series of horizontal lines for writing additional information, starting below the 'ADDITIONAL INFORMATION' header and extending down to the bottom of the page.

If more than one screen, show locations of each on sketch.