

Pearl R.
 X 116
 5-30-78

MISSISSIPPI
 BOARD OF WATER COMMISSIONERS
 416 North State Street
 Jackson, Mississippi 39201

CODED

WATER WELL DRILLERS LOG

5-30 1978 Bud Rutens Son Pearl River
 date well completed firm name county well located

LANDOWNER:
 Harold Duffield
 Carrie Mrs.
 (mailing address)

description of formations encountered	from	to
White Shale	0	12
White Sand	12	80
Blue Shale	80	460
Sand	460	520
Blue Shale	520	700
Grey Sand	700	740

WELL LOCATION:
 sec. 7 T. 6 N. R. 16 E.
 2 miles E of Ocean Springs
 (distance) (direction) (nearest town)

WELL PURPOSE: Home
 (home, irrigation, municipal, industrial)

WELL COMPLETION DATA:

(1) diameter (inches) 2 in
 (2) total depth (feet) 740
 (3) static water level (feet) 10 below top of ground.
 (4) casing 1/2 in (material) 740 (depth)
 (size) if telescope see back.
 (5) screen 2 x 10 (length) 730 (depth to top)
 12 (size) Stainless Steel (material)
 (6) pump 1/2 (HP) (yield gpm)
 flo (type power)
 (7) electric log 1/2 (yes or no)

(organization running log)

(8) how well bottom plugged
 Sand Shale

DRILLERS REMARKS:


CODED

RECEIVED

JUL 31 1978

If well telescopes please sketch and show depths.

GROUND LEVEL

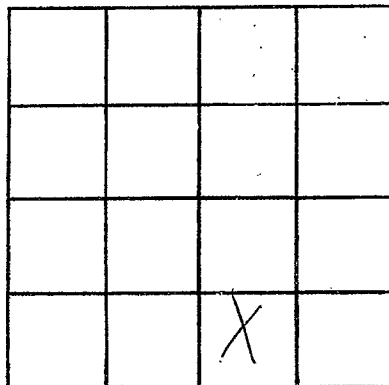

SECTION _____

Please indicate well location X.

ADDITIONAL INFORMATION

If more than one screen,
show locations of each on sketch.