

Pearl River
X 117
9-15-79

MISSISSIPPI
 BOARD OF WATER COMMISSIONERS
 416 North State Street
 Jackson, Mississippi 39201

CODED

WATER WELL DRILLERS LOG

9-15-79 19 Penton Well Serv Pearl River
 date well completed firm name county well located

LANDOWNER: Tommy Thiapen
Picayune Ms.
 (mailing address)
 WELL LOCATION:
 sec. 18 T. 6 S. R. 16 W.
0 miles East of Picayune
 (distance) (direction) (nearest town)

description of formations encountered	from	to
Surface Clay	0	20
Sand	20	40
Blue Clay	40	200
Sand	200	240
Blue Clay	240	500
Sand	500	530
Blue clay	530	980
Sand	980	1078

WELL PURPOSE: home
 (home, irrigation, municipal, industrial)

WELL COMPLETION DATA:
 (1) diameter (inches) 2"
 (2) total depth (feet) 1078'
 (3) static water level (feet) Flow below above top of ground.
 (4) casing Galv 1058'
 (material) (depth)
2" if telescope see back.
 (size)
 (5) screen 20' 1058'
 (length) (depth to top)
2" S. Steel
 (size) (material)
 (6) pump — —
 (HP) (yield gpm)
 (type power)
 (7) electric log No
 (yes or no)
 (organization running log)
 (8) how well bottom plugged Bwoalve


CODED

*Rec'd 10-2-79
Dm*

DRILLERS REMARKS:

If well telescopes please sketch and show depths.

GROUND LEVEL

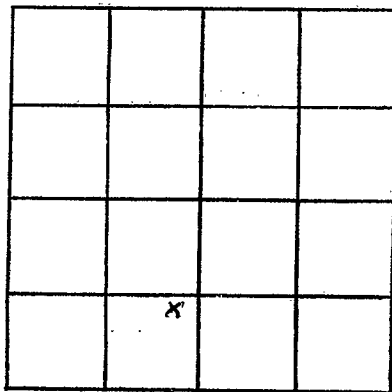

SECTION 18

Please indicate well location X.

ADDITIONAL INFORMATION

A series of horizontal lines for writing additional information.

If more than one screen, show locations of each on sketch.