

Pearl River
 X-118
 10-29-79

MISSISSIPPI
 BOARD OF WATER COMMISSIONERS
 416 North State Street
 Jackson, Mississippi 39201

WATER WELL DRILLERS LOG

10/29 date well completed 1979 Bud Dorton firm name Pearl River county well located

LANDOWNER: <i>Daley Lee</i>	description of formations encountered	from	to
<i>A7.3 Carriere Miss</i>			
	<i>Blue Shale</i>	<i>70</i>	<i>580</i>
	<i>Blue Sand</i>	<i>580</i>	<i>571</i>

(mailing address)
 WELL LOCATION:
 sec. 6 T. 6 N. R. 16 W.
2 miles *East* of *Piquette*
 (distance) (direction) (nearest town)


WELL PURPOSE: *home*
 (home, irrigation, municipal, industrial)

- WELL COMPLETION DATA:
- diameter (inches) 2"
 - total depth (feet) 571
 - static water level (feet) 486 ~~above~~ *above*
 top of ground.
 - casing galv. 561
 (material) (depth)
 - 70 If telescope see back.
 (size)
 - screen 10 ft. 561
 (length) (depth to top)
 - 1/2" Steel
 (size) (material)
 - pump _____ (HP) _____ (yield gpm)
 (type power)
 - electric log no
 (yes or no)
 - (organization running log)
 - how well bottom plugged _____

DRILLERS REMARKS: *no pump furnished*

If well telescopes please sketch and show depths.

GROUND LEVEL

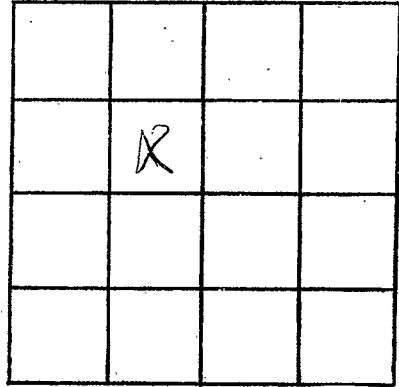

SECTION _____

Please indicate well location X.

ADDITIONAL INFORMATION

If more than one screen,
show locations of each on sketch.