

MISSISSIPPI DEPARTMENT OF NATURAL RESOURCES

Bureau of Land and Water Resources

Southport Mall

P.O. Box 10631

Jackson, Mississippi 39209

WATER WELL DRILLERS LOG

6
CODED

Pearl River
X 119
5-13-80

5-13

1980 Pentone Well Sew Pearl River

date well completed

firm name

county well located

LANDOWNER: Cliff Mitchell

Rt.

Picayune, MS.
(mailing address)

WELL LOCATION:

sec. 8 T 6 S R 16 E W
1 1/2 miles East of Picayune
(distance) (direction) (nearest town)

WELL PURPOSE: Home
(home, irrigation, municipal, industrial)

WELL COMPLETION DATA:

- (1) diameter (inches) 2
- (2) total depth (feet) 657
- (3) static water level (feet) Flow ^{below} above top of ground.
- (4) casing Galv. 647
(material) (depth)
2 if telescope see back.
(size)
- (5) screen 10' 647
(length) (depth to top)
2 S. Steel
(size) (material)
- (6) pump 2 10
(HP) (yield gpm)
NO
(type power)
- (7) electric log NO.
(yes or no)
(organization running log)
- (8) how well bottom plugged B.W. Valve

description of formations encountered

from to

Surface Clay	0	10
Sand	10	25
Blue Clay	25	340
Fine Sand	340	390
Blue clay	390	620
Sand	620	657

CODED

DEPT. OF NATURAL RESOURCES
BUREAU OF LAND & WATER RESOURCES


JUN 3 - 1980

RECEIVED

DRILLERS REMARKS:

If well telescopes please sketch and show depths.

GROUND LEVEL

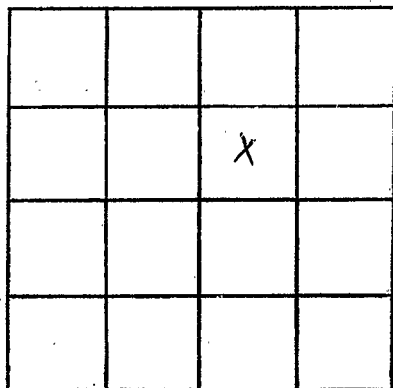

SECTION 8

Please indicate well location X.

ADDITIONAL INFORMATION

Lined area for entering additional information.

If more than one screen, show locations of each on sketch.