

Pearl River  
 X 123  
 6-24-75

MISSISSIPPI  
 BOARD OF WATER COMMISSIONERS  
 416 North State Street  
 Jackson, Mississippi 39201

CODED

WATER WELL DRILLERS LOG

6-24-75 date well completed      95 Lumbkin Well Ser. Pearl River firm name      Pearl River county well located

LANDOWNER:  
 Millerub Baptist Church  
 Pecayune, Miss.  
 (mailing address)

description of formations encountered	from	to
Clay	0	15
Sand	15	50
Clay	50	265
Sand	265	315
Clay	315	580
Fine Sand	580	665
Good Sand	665	735
Clay	735	775
Sand	775	820
Clay	820	920
Sand	920	1100
Clay	1100	1155
Sand	1155	1315
Clay	1315	1420
Sand	1420	1471

WELL LOCATION:  
 sec 17 T 60 N R 16 E 13V  
 3 miles East of Pecayune  
 (distance) (direction) (nearest town)

WELL PURPOSE: Home  
 (home, irrigation, municipal, industrial)


- WELL COMPLETION DATA:
- (1) diameter (inches) 2"
  - (2) total depth (feet) 1471'
  - (3) static water level (feet) 14" below above top of ground.
  - (4) casing Gal. 1450'  
 (material) (depth)  
 2" if telescope see back.  
 (size)
  - (5) screen 21' 1450'  
 (length) (depth to top)  
 2" Stainless Steel  
 (size) (material)
  - (6) pump No 40-10LBS.  
 (HP) (yield gpm)  
 No  
 (type power)
  - (7) electric log No  
 (yes or no)  
 No  
 (organization running log)
  - (8) how well bottom plugged Sand Shrub

RECEIVED  
 JUL 24 1975

DRILLERS REMARKS:

If well telescopes please sketch and show depths.

GROUND LEVEL

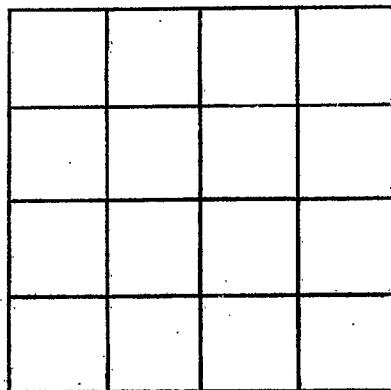

SECTION \_\_\_\_\_

Please indicate well location X.

ADDITIONAL INFORMATION

If more than one screen, show locations of each on sketch.