

Pearl River
X 125
7-2-75

MISSISSIPPI
 BOARD OF WATER COMMISSIONERS
 416 North State Street
 Jackson, Mississippi 39201

CODED


WATER WELL DRILLERS LOG

7-2- 1975 Lumpkin Well Ser. Pearl River
 date well completed firm name county well located

LANDOWNER:	description of formations encountered	from	to
Mr. Mickey Stegall Pecayune, Miss. (mailing address)	Clay Sand Clay Fine Sand Clay Sand	0 35 70 165 200 325	35 70 165 200 325 370
WELL LOCATION: sec. <u>8</u> T. <u>4</u> N. R. <u>16</u> E. ^{13V} <u>2 1/2</u> miles <u>East</u> of <u>Pecayune</u> (distance) (direction) (nearest town)			
WELL PURPOSE: <u>Home-</u> (home, irrigation, municipal, industrial)			
WELL COMPLETION DATA: (1) diameter (inches) <u>2"</u> (2) total depth (feet) <u>367'</u> (3) static water level (feet) <u>25'</u> below top of ground. (4) casing <u>P.V.C., 361'</u> (material) (depth) <u>9"</u> if telescope see back. (size) (5) screen <u>6', 361'</u> (length) (depth to top) <u>2"</u> <u>P.V.C.</u> (size) (material) (6) pump <u>1/2</u> <u>230 4</u> (HP) (yield gpm) <u>Elec.</u> (type power) (7) electric log <u>No</u> (organization running log) <u>No</u> (organization running log) (8) how well bottom plugged <u>Small Shell</u>			
DRILLERS REMARKS:	RECEIVED JUL 14 1975 MISS. Bd. OF WATER COMM.		

If well telescopes please sketch and show depths.

GROUND LEVEL

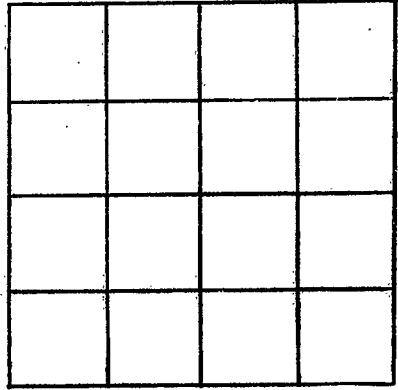

SECTION _____

Please indicate well location X.

ADDITIONAL INFORMATION

If more than one screen, show locations of each on sketch.