

Pearl River  
 X 127  
 1-68

MISSISSIPPI  
 BOARD OF WATER COMMISSIONERS  
 416 North State Street  
 Jackson, Mississippi 39201

13V

WATER WELL DRILLERS LOG

1-18-68 1968 Pearson well serv Pearl River  
 date well completed firm name county well located

LANDOWNER: Junior N. Fore

Rt 1 Box 210

Picayune MISS  
 (mailing address)

WELL LOCATION:

sec. 16 T. 6 S. R. 16 W.  
3 miles East of Picayune  
 (distance) (direction) (nearest town)

WELL PURPOSE: Home  
 (home, irrigation, municipal, industrial)

WELL COMPLETION DATA: 4 1/2 Drilled

(1) diameter (inches) 2"  
 (2) total depth (feet) 1029

(3) static water level (feet) Flow above  
 top of ground. +19'

(4) casing Black steel 1009  
 (material) (depth)  
2" if telescope see back.  
 (size)

(5) screen 20', 1009  
 (length) (depth to top)  
015- 2", S. Steel  
 (size) (material)


(6) pump \_\_\_\_\_  
 (HP) (yield gpm)  
 (type power)

(7) electric log No  
 (yes or no)  
 (organization running log)

(8) how well bottom plugged B.W. Valve

description of formations encountered	from	to
Surface Clay	0	22
Sand	22	58
Blue Clay	58	80
Black Mud & Sand	80	115
Blue Clay	115	255
Grey Sand	255	288
Blue Clay	288	465
Fine sand	465	482
Blue Clay	482	558
Grey Sand	558	597
Blue clay	597	640
Mud	640	680
Grey sand	680	714
Blue Clay	714	772
Grey sand	772	810
Blue Clay	810	838
Grey sand	838	887
Blue Clay	887	925
Fine sand	925	940
Grey sand	940	1029

DRILLERS REMARKS: 8 lbs.  
Pressure at Ground  
level

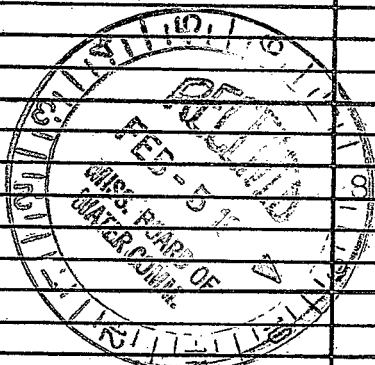

If well telescopes please sketch and show depths.

GROUND LEVEL

			X

SECTION 16

Please indicate well location X.

ADDITIONAL INFORMATION

If more than one screen, show locations of each on sketch.