

PEARL RIVER
X 128
3-10-73

MISSISSIPPI
 BOARD OF WATER COMMISSIONERS
 416 North State Street
 Jackson, Mississippi 39201

CODED

WATER WELL DRILLERS LOG

3-10 1973 Earl Ranton water well sem. Pearl River
 date well completed firm name county well located


LANDOWNER:	description of formations encountered	from	to
<u>W. L. Lee</u>			
<u>Picayune Miss.</u> (mailing address)	<u>Red Fine sd.</u>	<u>15</u>	<u>32</u>
WELL LOCATION: sect <u>12</u> T <u>6</u> N R <u>16</u> E <u>7</u> miles <u>East</u> of <u>Picayune</u> (distance) (direction) (nearest town)	<u>Coarse white sd.</u>	<u>32</u>	<u>54</u>
WELL PURPOSE: <u>Home</u> (home, irrigation, municipal, industrial)			
WELL COMPLETION DATA: (1) diameter (inches) <u>4.5</u> (2) total depth (feet) <u>54</u> (3) static water level (feet) <u>15</u> below above top of ground. (4) casing <u>P.V.C.</u> <u>49'</u> (material) (depth) <u>2"</u> if telescope see back. (size) (5) screen <u>5'</u> <u>49'</u> (length) (depth to top) <u>2"</u> <u>B.W.C.</u> (size) (material) (6) pump <u>1/2</u> <u>400 H.P.</u> (HP) (yield gpm) <u>Elect.</u> <u>7</u> (type power) (7) electric log <u>NO</u> (yes or no) (organization running log) (8) how well bottom plugged <u>Shoe.</u>			
DRILLERS REMARKS:			

CODED

MAR 27 1973

If well telescopes please sketch and show depths.

GROUND LEVEL

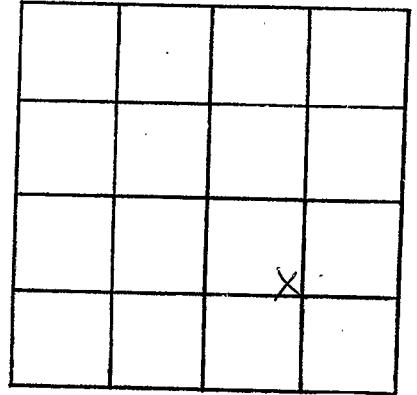

SECTION 12

Please indicate well location X.

ADDITIONAL INFORMATION

If more than one screen,
show locations of each on sketch.