

Pearl River  
 X 132  
 8-6-73

MISSISSIPPI  
 BOARD OF WATER COMMISSIONERS  
 416 North State Street  
 Jackson, Mississippi 39201

**CODED**

WATER WELL DRILLERS LOG

8-6-1973 date well completed  
 Simpkin Well Service firm name  
 Pearl River county well located


LANDOWNER: <i>Mr. Bertha Craddock</i>	description of formations encountered	from	to
<i>Craddock, Rt. 2</i>	<i>Clay</i>	<i>0</i>	<i>15</i>
<i>Carriere, Miss. 39420</i> (mailing address)	<i>Sand</i>	<i>15</i>	<i>35</i>
	<i>Clay</i>	<i>35</i>	<i>140</i>
	<i>Sand</i>	<i>140</i>	<i>195</i>
<b>WELL LOCATION:</b>			
sec. <i>8</i> T. <i>6</i> N R. <i>16</i> E <i>2 1/2</i> miles <i>E</i> of <i>Osage</i> (distance) (direction) (nearest town)			
<b>WELL PURPOSE:</b> <i>Home</i> (home, irrigation, municipal, industrial)			
<b>WELL COMPLETION DATA:</b>			
(1) diameter (inches) <i>2"</i>			
(2) total depth (feet) <i>195'</i>			
(3) static water level (feet) <i>18</i> <sup>below</sup> / <sub>above</sub> top of ground.			
(4) casing <i>Galv.</i> , <i>2"</i> (material) (depth)			
<i>2"</i> (size) If telescope see back.			
(5) screen <i>5'</i> , <i>189'</i> (length) (depth to top)			
<i>2"</i> , <i>Stainless Steel</i> (size) (material)			
(6) pump <i>1/2</i> , <i>500 gpm</i> (HP) (yield gpm)			
<i>Elect.</i> , <i>8</i> (type power)			
(7) electric log <i>No</i> (yes or no)			
<i>No</i> (organization running log)			
(8) how well bottom plugged <i>Sand</i> <i>Shark</i>			
<b>DRILLERS REMARKS:</b>			

**CODED**

AUG 10 1973

If well telescopes please sketch and show depths.

GROUND LEVEL

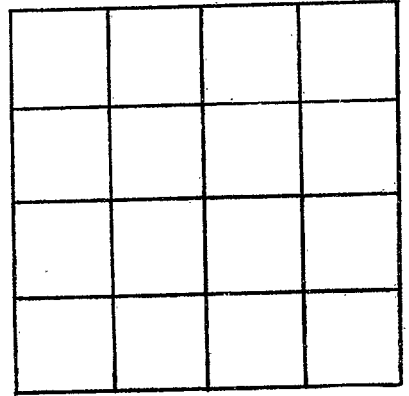

SECTION \_\_\_\_\_

Please indicate well location X.

ADDITIONAL INFORMATION

If more than one screen, show locations of each on sketch.