

Pearl River
 133
 9-5-75

MISSISSIPPI
 BOARD OF WATER COMMISSIONERS
 416 North State Street
 Jackson, Mississippi 39201

WATER WELL DRILLERS LOG

9/5 1975 Bud Penton & Son Pearl River
 date well completed firm name county well located

LANDOWNER: Mike Penton

Picayune Miss.
 (mailing address)

WELL LOCATION:
 sec. 8 T. 6 N. R. 16 E.
1 miles East of Picayune
 (distance) (direction) (nearest town)


WELL PURPOSE: Home
 (home, irrigation, municipal, industrial)

WELL COMPLETION DATA:

- (1) diameter (inches) 2 1/2
- (2) total depth (feet) 1088
- (3) static water level (feet) 44 ^{below} ~~above~~ top of ground above
- (4) casing 1088
 (material) (depth)
- _____ if telescope see back.
 (size)
- (5) screen 30 1058
 (length) (depth to top)
16" st steel
 (size) (material)
- (6) pump _____
 (HP) (yield gpm)
- _____ (type power)
- (7) electric log no
 (yes or no)
- _____ (organization running log)
- (8) how well bottom plugged sharp

description of formations encountered	from	to
white shale	0	41
white sand	41	125
blue shale	125	267
blue sand	267	303
blue shale	303	326
gray sand	326	596
blue shale	596	985
gray sand	985	1088

DRILLERS REMARKS:

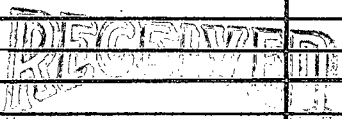

If well telescopes please sketch and show depths.

GROUND LEVEL

			X

SECTION _____

Please indicate well location X.

ADDITIONAL INFORMATION

If more than one screen,
show locations of each on sketch.