

Pearl River Co.

MISSISSIPPI DEPARTMENT OF NATURAL RESOURCES

Bureau of Land and Water Resources

Southport Mall

P.O. Box 10631

Jackson, Mississippi 39209

WATER WELL DRILLERS LOG

CODED

Hancock

X 001 X138

4-3-85

4-3-1985
date well completed

85 Water Well Drg.
firm name

Hancock
county well located

LANDOWNER: R.W. Palmer Jr.
Pt. 1, Box 290K
Picoyane Mrs.
(mailing address)

| description of formations encountered | from | to |
|---------------------------------------|------|-----|
| Clay | 0 | 21 |
| Clay Sand | 21 | 52 |
| Clay-Silt | 52 | 120 |
| Fine Sand | 120 | 136 |
| Clay-Silt | 136 | 235 |
| Flne Sd | 235 | 248 |
| Clay-Silt | 248 | 304 |
| Clay Sd | 304 | 359 |

WELL LOCATION:
sec. 21 T-6 N R-16 E
14 miles N/W of Belm
(distance) (direction) (nearest town)

WELL PURPOSE: Home
(home, irrigation, municipal, industrial)

WELL COMPLETION DATA:

- (1) diameter (inches) 2"
- (2) total depth (feet) 357
- (3) static water level (feet) 5 below top of ground.
- (4) casing PVC, 347, (material) (depth)
- (size) If telescope see back.
- (5) screen 10' (length) (depth to top)
- 2" PVC (size) (material)
- (6) pump owner (HP) (yield gpm)
- (type power)
- (7) electric log no (yes or no)
- N/A (organization running log)
- (8) how well bottom plugged BWV

CODED


RECEIVED
JUN 17 1985

Department of Natural Resources
Bureau of Land & Water Resources

DRILLERS REMARKS: well flowed approx 15 GPM - 3 PSI at well head.

If well telescopes please sketch and show depths.

GROUND LEVEL

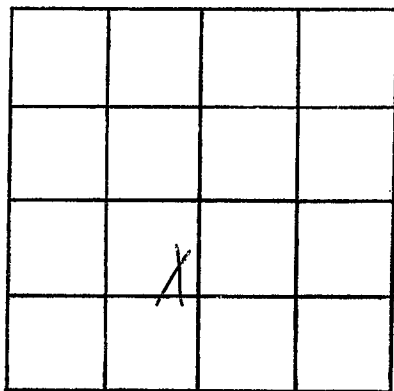

SECTION _____

Please indicate well location X.

ADDITIONAL INFORMATION

If more than one screen,
show locations of each on sketch.