

MISSISSIPPI DEPARTMENT OF NATURAL RESOURCES

Bureau of Land and Water Resources

Southport Mall

P.O. Box 10631

Jackson, Mississippi 39209

WATER WELL DRILLERS LOG

CODED

PEARL RIVER  
X #36139

5-28 1985 PENTON Well Service Pearl River  
date well completed firm name county well located

LANDOWNER: TOMMY THIGPEN  
PICAYUNE, MS  
(mailing address)

WELL LOCATION:  
sec. 7 T. 6 S. R. 16 W.  
1 miles E of PICAYUNE  
(distance) (direction) (nearest town)

WELL PURPOSE: HOME  
(home, irrigation, municipal, industrial)

- WELL COMPLETION DATA:
- (1) diameter (inches) 2"
  - (2) total depth (feet) 1050'
  - (3) static water level (feet) Flow ~~unknown~~ above top of ground.
  - (4) casing PVC, 1030'  
(material) (depth)  
2"  
(size) if telescope see back.
  - (5) screen 20', 1030'  
(length) (depth to top)  
2", PVC  
(size) (material)
  - (6) pump \_\_\_\_\_ (HP) \_\_\_\_\_ (yield gpm)  
(type power)
  - (7) electric log NO  
(yes or no)  
(organization running log)
  - (8) how well bottom plugged BW

description of formations encountered	depth	
	from	to
CLAY	0	20
SAND	20	30
CLAY	30	370
SAND	370	405
CLAY	405	740
SAND	740	780
CLAY	780	950
SAND	950	1050

CODED


RECEIVED  
JUL 8 - 1985

Department of Natural Resources  
Bureau of Land & Water Resources

DRILLERS REMARKS:

If well telescopes please sketch and show depths.

GROUND LEVEL

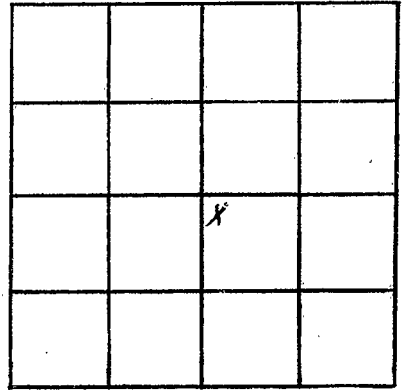

SECTION 7

Please indicate well location X.

ADDITIONAL INFORMATION

If more than one screen,  
show locations of each on sketch.