

**PEARL RIVER**  
 X 141  
 3-11-76

MISSISSIPPI  
 BOARD OF WATER COMMISSIONERS  
 416 North State Street  
 Jackson, Mississippi 39201

CODED

WATER WELL DRILLERS LOG

March 18 1976 Sumpter Well Co. Paul River  
 date well completed firm name county well located

LANDOWNER:  
Muskey Segall  
Picayune, Miss.  
 (mailing address)

WELL LOCATION:  
 sec. 8 T. N R. 16 E  
6 S 16 E  
9 1/2 miles East of Picayune  
 (distance) (direction) (nearest town)


WELL PURPOSE: Home  
 (home, irrigation, municipal, industrial)

- WELL COMPLETION DATA:
- (1) diameter (inches) 2"
  - (2) total depth (feet) 1134
  - (3) static water level (feet) 5" below above top of ground.
  - (4) casing Gal. 1114  
 (material) (depth)  
2" if telescope see back.  
 (size)
  - (5) screen 20' 1114'  
 (length) (depth to top)  
2" Stainless Steel  
 (size) (material)
  - (6) pump None 415  
 (HP) (yield gpm)  
None  
 (type power)
  - (7) electric log no  
 (yes or no)  
no  
 (organization running log)
  - (8) how well bottom plugged Sealed

description of formations encountered	from	to
Clay	0	20
Sand	20	65
Clay	65	160
Fine Sand	160	200
Clay	200	320
Sand	320	360
Clay	360	420
Fine Sand	420	445
Clay	445	705
Hard Sand	705	800
Clay	800	870
Fine Sand	870	910
Clay	910	995
<del>Hard Sand</del>	995	1134

CODED

*Pump  
 not running*

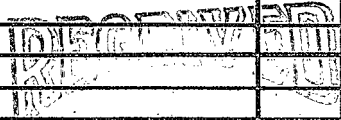


MAR 25 1976

DRILLERS REMARKS:

If well telescopes please sketch and show depths.

GROUND LEVEL

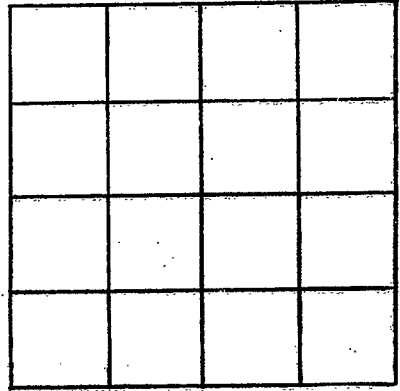

SECTION \_\_\_\_\_

Please indicate well location X.

ADDITIONAL INFORMATION

If more than one screen, show locations of each on sketch.