

Pearl River
143
10-8-76

MISSISSIPPI
BOARD OF WATER COMMISSIONERS
416 North State Street
Jackson, Mississippi 39201

CODED

WATER WELL DRILLERS LOG

10-8 date well completed
131 76 Pantons Well Serv firm name
Pearl River county well located

LANDOWNER: Andel Stewart
Rt.
Picayune MISS
(mailing address)

description of formations encountered	from	to
Surface Clay	0	530
Sand	530	780
Blue clay	780	870
Sand	870	930
Blue Clay	930	1600
Sand	1600	1672

WELL LOCATION:
sec. 9 T. 6 S. R. 16 W.
1 miles NE of Picayune
(distance) (direction) (nearest town)

WELL PURPOSE: Home
(home, irrigation, municipal, industrial)

- WELL COMPLETION DATA:
- (1) diameter (inches) 2
 - (2) total depth (feet) 1672
 - (3) static water level (feet) Flow ^{below} above top of ground.
 - (4) casing Galv. 1652
(material) (depth)
 - 2 If telescope see back.
(size)
 - (5) screen 20' 1652
(length) (depth to top)
 - 2 S. Steel
(size) (material)
 - (6) pump 38
(HP) (yield/gpm)
 - (type power)
 - (7) electric log NO
(yes or no)
 - (organization running log)
 - (8) how well bottom plugged Bl. Valve

CODED


RECEIVED
NOV 11 1976

DRILLERS REMARKS: 9 lbs. Pressure

MISS. BD. OF WATER COMM

If well telescopes please sketch and show depths.

GROUND LEVEL

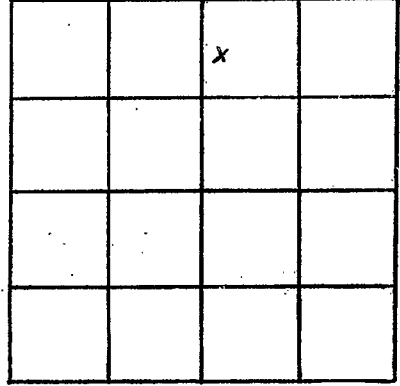

SECTION 9

Please indicate well location X.

ADDITIONAL INFORMATION

If more than one screen, show locations of each on sketch.