

PEARL RIVER  
 X 145

MISSISSIPPI  
 BOARD OF WATER COMMISSIONERS  
 416 North State Street  
 Jackson, Mississippi 39201

CODED

WATER WELL DRILLERS LOG

*Real River*

6-28 1978 date well completed  
 POUNCEY WATER WELL DRILLING firm name  
 Pearl River county well located

LANDOWNER: *Bill Edwards*  
*Sylvan Rd.*  
*Pearl River, MS*  
 (mailing-address)

WELL LOCATION:  
 sec. *18* T *X* N R *16* E  
*3* miles *NE* of *Pearl River*  
 (distance) (direction) (nearest town)

WELL PURPOSE: *home*  
 (home, irrigation, municipal, industrial)

- WELL COMPLETION DATA:
- (1) diameter (inches) *2*
  - (2) total depth (feet) *730*
  - (3) static water level (feet) *Flow* below above top of ground.
  - (4) casing *2* *710*  
 (material) (depth)  
*2* If telescope see back.  
 (size)
  - (5) screen *20* *710*  
 (length) (depth to top)  
*2* (size) *1/2 inch* (material)
  - (6) pump *1/2* *Rooster*  
 (HP) (yield gpm)  
*AC*  
 (type power)
  - (7) electric log */*  
 (yes or no)  
 (organization running log)
  - (8) how well bottom plugged */*

description of formations encountered	from	to
<i>Clay</i>	<i>0</i>	<i>6</i>
<i>Sd. Rocks Bed</i>	<i>6</i>	<i>32</i>
<i>Clay Sd - Mat Gravel</i>	<i>32</i>	<i>544</i>
<i>Dark Hd. sil</i>		
<i>Red Clay</i>	<i>644</i>	<i>702</i>
<i>Sd. P ground</i>	<i>702</i>	<i>730</i>

CODED


RECEIVED

AUG - 1 1978

DRILLERS REMARKS: *Flood well.*

If well telescopes please sketch and show depths.

GROUND LEVEL

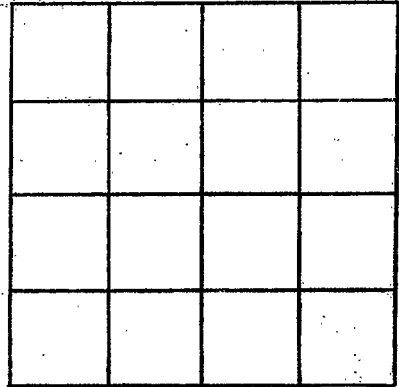

SECTION \_\_\_\_\_

Please indicate well location X.

ADDITIONAL INFORMATION

If more than one screen, show locations of each on sketch.