

Paul River
X 147

MISSISSIPPI
BOARD OF WATER COMMISSIONERS
416 North State Street
Jackson, Mississippi 39201

CODED

WATER WELL DRILLERS LOG 159

4-18 1982 Penton Well Service Paul River
date well completed firm name county well located

LANDOWNER: Ezrl Grabert
Rt. 3 Box 306
Carrere MS.
(mailing address)

description of formations encountered	from to	
Surface Clay	0	20
Sand	20	65
Clay	65	500
Sand	500	590

CODED

WELL LOCATION:
 sec. 5 T. 6 N. R. 16 E.
S. W.
1 1/2 miles NE of Picayune
(distance) (direction) (nearest town)

WELL PURPOSE: Home
(home, irrigation, municipal, industrial)

- WELL COMPLETION DATA:
- (1) diameter (inches) 2
 - (2) total depth (feet) 590
 - (3) static water level (feet) Flow below top of ground.
 - (4) casing PVC 580
(material) (depth)
 - 2 If telescope see back.
(size)
 - (5) screen 10' 580
(length) (depth to top)
 - 2 PVC
(size) (material)
 - (6) pump (HP) (yield gpm)
 - (type power)
 - (7) electric log NO
(yes or no)

Pump

(organization running log)

DEPT. OF NATURAL RESOURCES
BUREAU OF LAND & WATER RESOURCES

(8) how well bottom plugged B.W. Valve


MAY - 6 1982

DRILLERS REMARKS:

RECEIVED

If well telescopes please sketch and show depths.

GROUND LEVEL

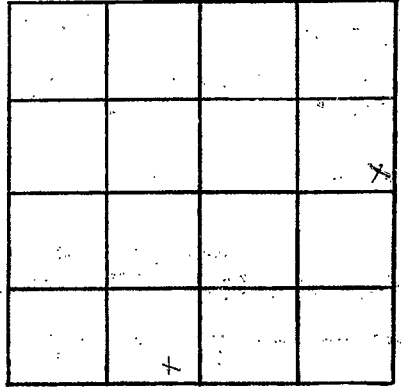

SECTION 5

Please indicate well location X.

ADDITIONAL INFORMATION

If more than one screen, show locations of each on sketch.