

Pearl River
 X 148
 3-67

MISSISSIPPI
 BOARD OF WATER COMMISSIONERS
 416 North State Street
 Jackson, Mississippi 39201

CODED

WATER WELL DRILLERS LOG

3-14 date well completed 1967 Penton Well Serv firm name Pearl River county well located

LANDOWNER: George Spiers

| description of formations encountered | from | to |
|---------------------------------------|----------|------|
| | Red Clay | 0 |
| White Sand | 18 | 52 |
| Blue Clay | 52 | 154 |
| Grey Sand | 154 | 168 |
| Blue Clay | 168 | 232 |
| Grey Sand | 232 | 275 |
| Blue Clay | 275 | 380 |
| Grey Sand | 380 | 428 |
| Blue Clay | 428 | 532 |
| Grey Sand | 532 | 550 |
| Blue Clay | 550 | 708 |
| Grey Sand | 708 | 739 |
| Blue Clay | 739 | 948 |
| Grey Sand | 948 | 1028 |

Rt 2 Box 105A
 Carriere Miss
 (mailing address)

WELL LOCATION:


sec 7 T 6 S R 16 W
 1/4 miles East of Picayune
 (distance) (direction) (nearest town)

WELL PURPOSE: Home
 (home, irrigation, municipal, industrial)

WELL COMPLETION DATA:

- (1) diameter (inches) 2
- (2) total depth (feet) 1028
- (3) static water level (feet) +20 above top of ground.
- (4) casing Black Steel 1008 (material), (depth), 2" (size) if telescope see back.
- (5) screen 20' 1008 (length), (depth to top)
- (6) pump 012 2" S. Steel (size), (material)
- (7) electric log NO (yes or no)
- (8) how well bottom plugged BW Valve


CODED

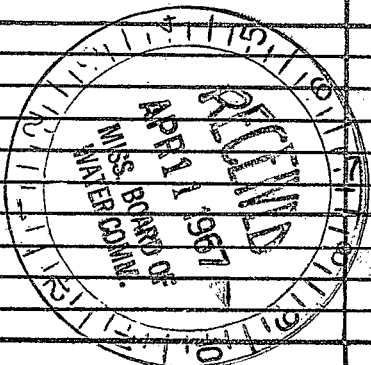

DRILLERS REMARKS:

If well telescopes please sketch and show depths.

GROUND LEVEL

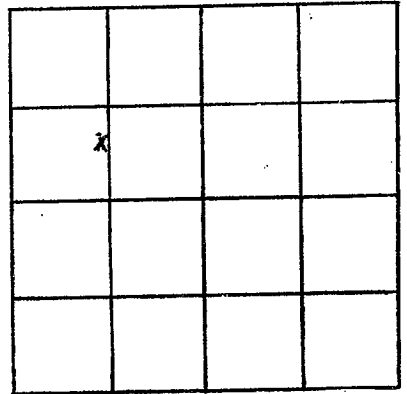

SECTION 7

Please indicate well location X.

ADDITIONAL INFORMATION

If more than one screen, show locations of each on sketch.