

Pearl River

X 150

2/25/78

MISSISSIPPI BOARD OF WATER COMMISSIONERS  
416 North State Street  
Jackson, Mississippi 39201

CODED

WATER WELL DRILLERS LOG

2-25-78

19. Penton Well Serv

Pearl River

date well completed

firm name

county well located

LANDOWNER: Bill Stegall

description of formations encountered

from

to

Picayune, Ms.

(mailing address)

Clay  
Sand + Gravel

0 10

Blue Clay

10 20

Sand

200 260

Blue Clay

260 730

Sand

730 850

Blue Clay

850 960

Sand

960 1070

WELL LOCATION:

sec. 18 T. 6 N R. 16 E  
S W

1 miles East of Picayune  
(distance) (direction) (nearest town)

WELL PURPOSE: Home  
(home, irrigation, municipal, industrial)

CODED

WELL COMPLETION DATA:

- (1) diameter (inches) 2"
- (2) total depth (feet) 1070
- (3) static water level (feet) Flow below above top of ground.
- (4) casing Galv. 1050  
(material) (depth)  
2" if telescope see back.  
(size)
- (5) screen 20' 1050  
(length) (depth to top)  
2" S. Steel  
(size) (material)
- (6) pump (HP) (yield gpm)  
(type power)
- (7) electric log NO  
(yes or no)  
(organization running log)
- (8) how well bottom plugged Bw Valve

Pump shut in

RECEIVED


APR 13 1978

MISS. BD. OF WATER COMM

DRILLERS REMARKS: 12 lbs -  
Pressure at Ground level

If well telescopes please  
sketch and show depths.

GROUND LEVEL

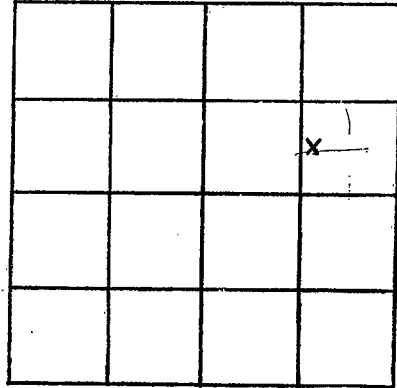

SECTION 18

Please indicate well location X.

ADDITIONAL INFORMATION

Lined area for additional information.

If more than one screen,  
show locations of each on sketch.