

MISSISSIPPI DEPARTMENT OF NATURAL RESOURCES

Bureau of Land and Water Resources

Southport Mall

P.O. Box 10631

Jackson, Mississippi 39209

WATER WELL DRILLERS LOG

CODED

PEARL RIVER
X151

7/3 1986 BUD PENTON PEARL RIVER
date well completed firm name county well located
WATER WELL SERVICE

LANDOWNER: JIM WILSEY
R T-1-Box 284
CARRIERE MISS.
(mailing address)


description of formations encountered	from	to
WHITE SHALE	0	32
WHITE SAND	32	55
BLUE SHALE	55	265
GRAY SAND	265	345
BLUE SHALE	345	785
GRAY SAND	785	865
BLUE SHALE	865	985
GRAY SAND	985	1048

WELL LOCATION:
sec. 8 T. 6 N R. 16 E
S W
2 miles E of PICAYUNE
(distance) (direction) (nearest town)

WELL PURPOSE: HOME
(home, irrigation, municipal, industrial)

CODED

- WELL COMPLETION DATA:
- (1) diameter (inches) 2"
 - (2) total depth (feet) 1048
 - (3) static water level (feet) 666 below above top of ground.
 - (4) casing PVC 1048 (material) (depth)
 - (size) if telescope see back.
 - (5) screen 30 1048 (length) (depth to top)
 - 12 PVC (size) (material)
 - (6) pump 70 (HP) (yield gpm)
 - (type power)
 - (7) electric log (yes or no)
 - no (organization running log)
 - (8) how well bottom plugged sand

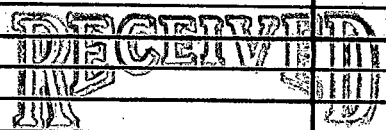


SEP 18 1986

Department of Natural Resources
Bureau of Land and Water Resources

DRILLERS REMARKS:

If well telescopes please sketch and show depths.

GROUND LEVEL

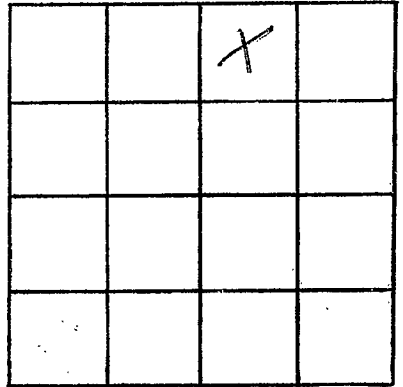

SECTION _____

Please indicate well location X.

ADDITIONAL INFORMATION

A series of horizontal lines for writing additional information.

If more than one screen, show locations of each on sketch.