

MISSISSIPPI DEPARTMENT OF NATURAL RESOURCES

Bureau of Land and Water Resources

Southport Mall BUD PENTON & SON
 P.O. Box 10631 WATER WELL SERVICE
 ROUTE BOX
 JACKSON, MISSISSIPPI 39209 CARRIERS, MS 39426
 PHONE 798-5324

Real River

X 152

WATER WELL DRILLERS LOG

BUD PENTON & SON
 WATER WELL SERVICE
 ROUTE 4 BOX 402
 CARRIERS, MS 39426
 PHONE 798-5324

10/15 1982
 date well completed

county well located

LANDOWNER: Mr. Woodruff

description of formations encountered

from to

304 Sycamore Road

<u>white shale</u>	<u>0</u>	<u>70</u>
<u>white sand</u>	<u>10</u>	<u>75</u>
<u>blue shale</u>	<u>70</u>	<u>120</u>
<u>blue sand</u>	<u>150</u>	<u>500</u>
<u>blue shale</u>	<u>500</u>	<u>700</u>
<u>gray sand</u>	<u>700</u>	<u>768</u>

(mailing address)

WELL LOCATION:

Sec. 8 T. 6 N. R. 16 E.
1 miles North of Piquette
 (distance) (direction) (nearest town)

WELL PURPOSE: home
 (home, irrigation, municipal, industrial)

WELL COMPLETION DATA:

- (1) diameter (inches) 2"
- (2) total depth (feet) 768
- (3) static water level (feet) 8 below above top of ground.
- (4) casing pvc 768
 (material) (depth)

_____ if telescope see back.
 (size)

- (5) screen 2x20 748
 (length) (depth to top)
- 1/2 pvc
 (size) (material)

- (6) pump no _____
 (HP) (yield gpm)

_____ (type power)

- (7) electric log no
 (yes or no)

_____ (organization running log)

- (8) how well bottom plugged hard
sharp


DRILLERS REMARKS:

DEPT. OF NATURAL RESOURCES
 BUREAU OF LAND & WATER RESOURCES

DEC-1 1982
 RECEIVED

If well telescopes please sketch and show depths.

GROUND LEVEL

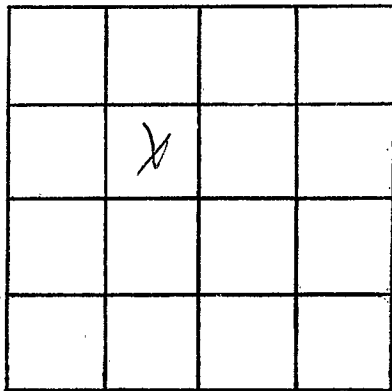

SECTION _____

Please indicate well location X.

ADDITIONAL INFORMATION

If more than one screen,
show locations of each on sketch.