

MISSISSIPPI DEPARTMENT OF NATURAL RESOURCES

Bureau of Land and Water Resources

Southport Mall

P.O. Box 10631

Jackson, Mississippi 39209

WATER WELL DRILLERS LOG

BOUNCEY WATER WELL DRILLING

Paul River

PEARL RIVER
XISA
7-17-86

CODED

7-17 19*86*
 date well completed

firm name

county well located

LANDOWNER:

Billy Hite

Hwy 43 E Picayune

(mailing address)

WELL LOCATION:

sec. *17* T. *6* N. R. *16* E
 S W
2 1/2 miles *E* of *Picayune*
 (distance) (direction) (nearest town)

WELL PURPOSE:

Home
 (home, irrigation, municipal, industrial)

WELL COMPLETION DATA:

- (1) diameter (inches) *2*
- (2) total depth (feet) *746*
- (3) static water level (feet) *11* below above top of ground.
- (4) casing *1 1/2* *731*
 (material) (depth)
2 if telescope see back.
 (size)
- (5) screen *15* *731*
 (length) (depth to top)
2 *DVE*
 (size) (material)
- (6) pump *3/4* *15*
 (HP) (yield gpm)
AC
 (type power)
- (7) electric log _____
 (yes or no)


 (organization running log)
- (8) how well bottom plugged *Sealed*

description of formations encountered

from to

<i>top</i>	<i>0</i>	<i>12</i>
<i>SD</i>	<i>12</i>	<i>31</i>
<i>gravel</i>	<i>31</i>	<i>48</i>
<i>SD - G ground</i>	<i>48</i>	<i>61</i>
<i>Clay gravel silt</i>	<i>61</i>	<i>640</i>
<i>SD to G ground</i>	<i>640</i>	<i>720</i>
<i>SD to G ground</i>	<i>720</i>	<i>746</i>

CODED

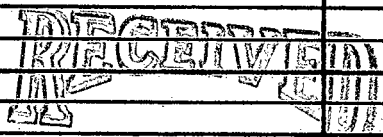


SFP 2 9 1986

Department of Natural Resources
 Bureau of Land and Water Resources

DRILLERS REMARKS:

If well telescopes please sketch and show depths.

GROUND LEVEL

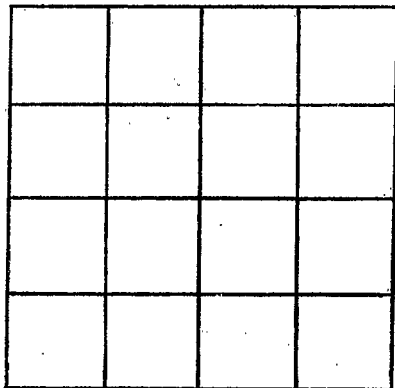

SECTION _____

Please indicate well location X.

ADDITIONAL INFORMATION

If more than one screen,
show locations of each on sketch.