

MISSISSIPPI DEPARTMENT OF NATURAL RESOURCES

Bureau of Land and Water Resources

Southport, Mississippi

P.O. Box 10631

Jackson, Mississippi 39209

WATER WELL DRILLERS LOG

Paul Luce
X 156

4/29 1987
date well completed

87 Bluffton
firm name

Pearl River
county well located

LANDOWNER: Greg and Gale
Box 43 South
Pacare, Miss
(mailing address)

description of formations encountered	from	to
<u>W. White Shale</u>	<u>0</u>	<u>35</u>
<u>White Sand</u>	<u>35</u>	<u>60</u>
<u>Blue Shale</u>	<u>60</u>	<u>130</u>
<u>Gray Sand</u>	<u>130</u>	<u>992</u>

CODED

WELL LOCATION:
sec. 18 T. 0 N. R. 16 E.
S. W.
2 miles East Pacare
(distance) (direction) (nearest town)

WELL PURPOSE: Shed
(home, irrigation, municipal, industrial)

- WELL COMPLETION DATA:
- (1) diameter (inches) 2 9/16
 - (2) total depth (feet) 992
 - (3) static water level (feet) 6 below/above top of ground.
 - (4) casing PCP 992
(material) (depth)
____ (size) if telescope see back.
 - (5) screen 20 972
(length) (depth to top)
12 PCP
(size) (material)
 - (6) pump no
(HP) (yield gpm)
(type power)
 - (7) electric log no
(yes or no)
(organization running log)
 - (8) how well bottom plugged shard

RECEIVED


JUN 16 1987

Department of Natural Resources
Bureau of Land & Water Resources

DRILLERS REMARKS:

If well telescopes please sketch and show depths.

GROUND LEVEL

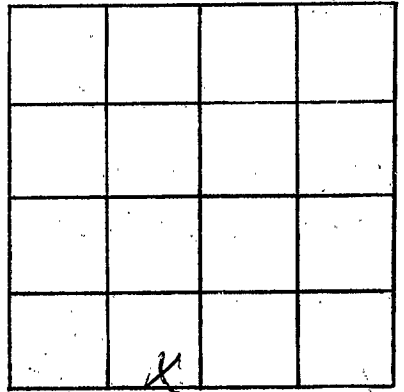

SECTION _____

Please indicate well location X.

ADDITIONAL INFORMATION

If more than one screen,
show locations of each on sketch.